



PARK RIDGE ROAD


HEWING PLACE

TILLERMAN PARADE

2
RP137533

SEE SHEET 2

All house connections are ϕ 100 unless otherwise noted.

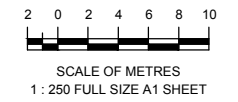


A1

REV NO	DATE	REVISION PURPOSE / DESCRIPTION	DRAWN	RPEQ	RPEQ No
A	26/10/2023	Builders Issue			

DRAWN	CM	21/08/2023
CHECKED	JHL	26/10/2023
APPROVED		



SH saunders havill group
 Saunders Havill Group Pty Ltd ABN 54 144 592 540
 head office 9 Thompson St Bowen Hills Q 4006
 phone: 600 633 5161 web: www.saundershavill.com
 ■ surveying ■ town planning ■ urban design ■ environmental management ■ landscape architecture

Drawing No: 10652 S 23 + 24 + 25 AC A

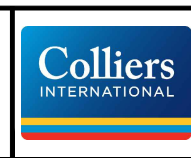

TILLERMAN - STAGE 1
 PARK RIDGE ROAD, PARK RIDGE
 PLAN OF ADAC SURVEY DATA
 SEWERAGE RETICULATION OW/182/2022

DRAWING STATUS	
AS CONSTRUCTED	
SHEET 1 OF 2 SHEETS	
DRAWING NO.	REV.
10652 S 23 AC	A

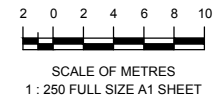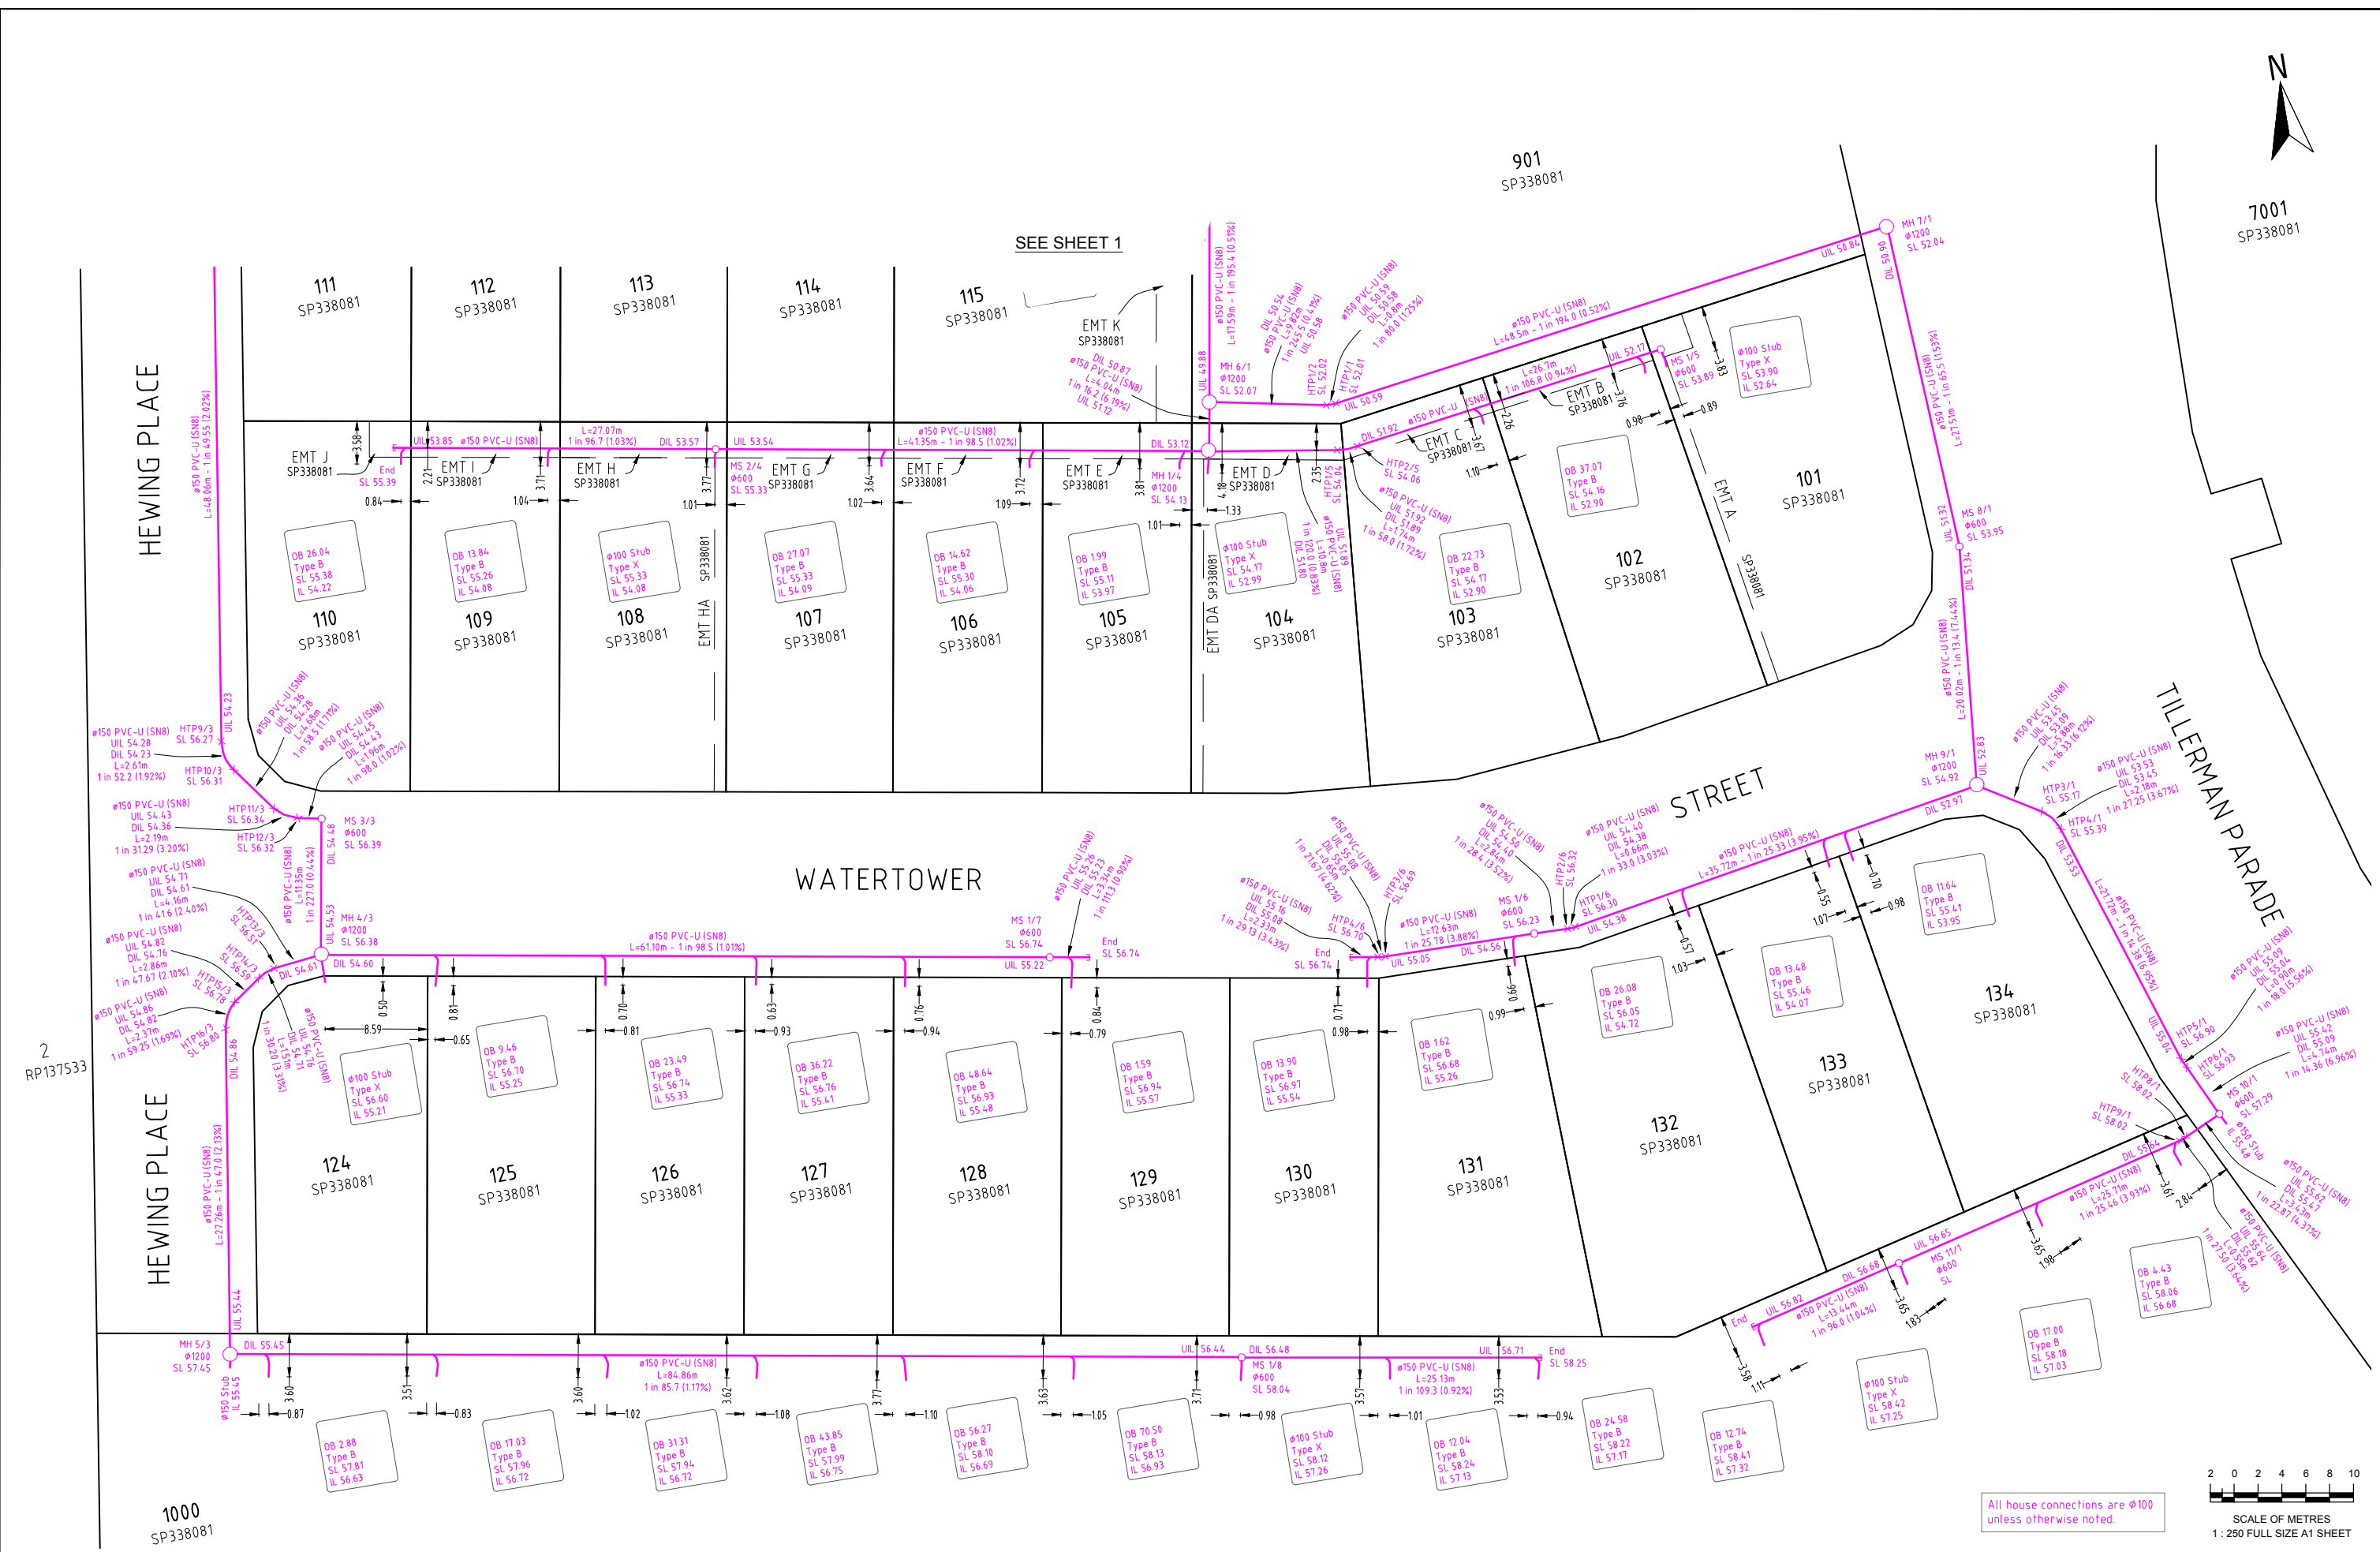

All house connections are ϕ 100 unless otherwise noted.

A1

REV NO	DATE	REVISION PURPOSE / DESCRIPTION	DRAWN	RPEQ	RPEQ No	INITIALS	DATE
A	26/10/2023	Builders Issue					

DRAWN	CM	21/08/2023
CHECKED	JHL	26/10/2023
APPROVED		

saunders havill group
 Saunders Havill Group Pty Ltd ABN 24 144 592 549
 head office 5 Thompson St Bowen Hills Q 4006
 phone: 600 633 5142 web: www.saundershavill.com
 ■ surveying ■ town planning ■ urban design ■ environmental management ■ landscape architecture



TILLERMAN - STAGE 1
 PARK RIDGE ROAD, PARK RIDGE
 PLAN OF ADAC SURVEY DATA
 SEWERAGE RETICULATION OW/182/2022

DRAWING STATUS AS CONSTRUCTED	
SHEET 2 OF 2 SHEETS	
DRAWING NO. 10652 S 23 AC	REV. A

Drawing No: 10652 S 23 + 24 + 25 AC A