




PARK RIDGE ROAD


TILLERMAN PARADE

2
RP137533

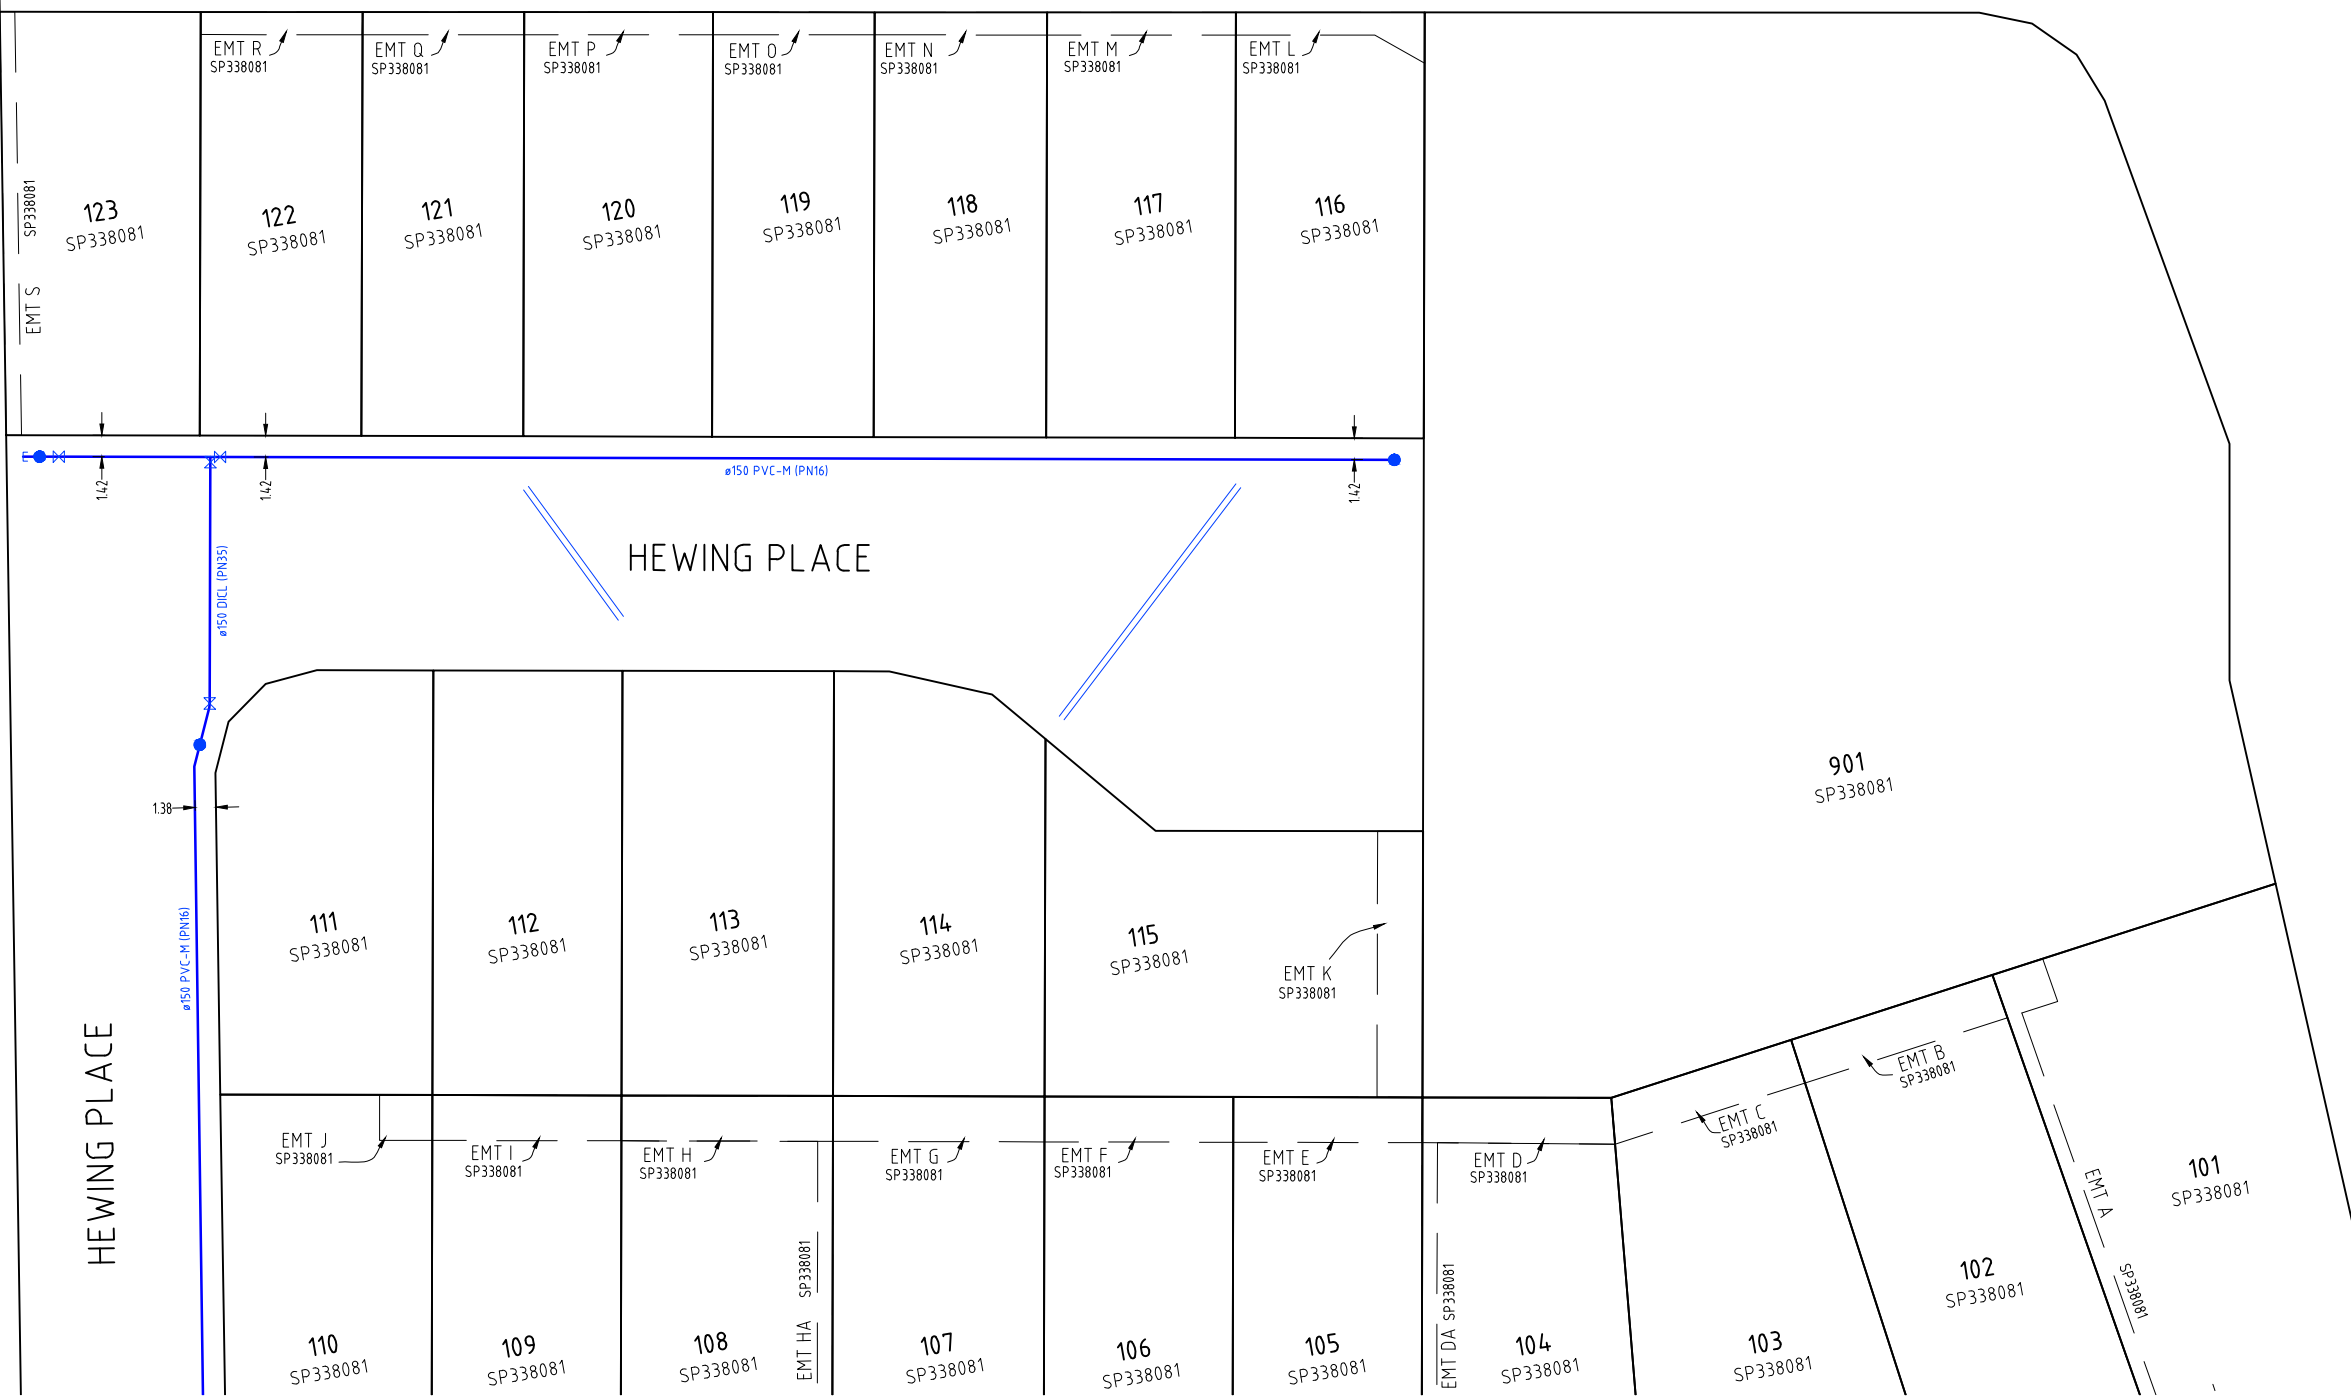

WATER FITTINGS LEGEND

	Hydrant
	Valve
	Bend
	Water Fitting
	Dead End Cap
	Reducer
	Water Meter
	Conduit Crossing and Service Pipe

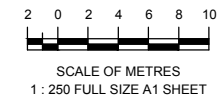


SEE SHEET 2

A1

REV NO	DATE	REVISION PURPOSE / DESCRIPTION	DRAWN	RPEQ	RPEQ No
A	26/10/2023	Builders Issue			

DRAWN	PS	04/10/2023
CHECKED	JHL	26/10/2023
APPROVED		

SH saunders havill group
 Saunders Havill Group Pty Ltd ABN 24 144 572 540
 head office 5 Thompson St Bowen Hills Q 4006
 phone: 090 433 5142 web: www.saundershavill.com
 ■ surveying ■ town planning ■ urban design ■ environmental management ■ landscape architecture

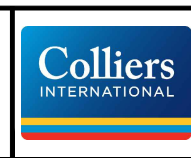

TILLERMAN - STAGE 1
 PARK RIDGE ROAD, PARK RIDGE
 PLAN OF ADAC SURVEY DATA
 WATER RETICULATION OW/87/2023


DRAWING STATUS AS CONSTRUCTED	
SHEET 1 OF 3 SHEETS	
DRAWING NO. 10652 S 24 AC	REV. A

Drawing No: 10652 S 23 + 24 + 25 AC A



WATER FITTINGS LEGEND

	Hydrant
	Valve
	Bend
	Water Fitting
	Dead End Cap
	Reducer
	Water Meter
	Conduit Crossing and Service Pipe

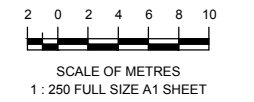

A1

REV NO	DATE	REVISION PURPOSE / DESCRIPTION	DRAWN	RPEQ	RPEQ No
A	26/10/2023	Builders Issue			

DRAWN	PS	04/10/2023
CHECKED	JHL	26/10/2023
APPROVED		

SH saunders havill group
 Saunders Havill Group Pty Ltd ABN 24 144 572 540
 head office 9 Thompson St Bowen Hills Q 4006
 phone 090 453 5142 web www.saundershavill.com
 ■ surveying ■ town planning ■ urban design ■ environmental management ■ landscape architecture



TILLERMAN - STAGE 1
PARK RIDGE ROAD, PARK RIDGE
PLAN OF ADAC SURVEY DATA
WATER RETICULATION OW/87/2023

DRAWING STATUS AS CONSTRUCTED	
SHEET 2 OF 3 SHEETS	
DRAWING NO. 10652 S 24 AC	REV. A

Drawing No: 10652 S 23 + 24 + 25 AC A