

SCHEDULE OF FITTINGS

①	Ø150 11.25° Bend
②	Ø150 22.5° Bend
③	Ø150 45° Bend
④	Ø150 90° Bend
⑤	Ø150 Dead End Cap
⑥	Ø150 Hydrant
⑦	Ø150 Valve
⑧	Ø150 x Ø150 Tee

WATER FITTINGS LEGEND

	Hydrant
	Valve
	Bend
	Water Fitting
	Dead End Cap
	Reducer
	Water Meter
	Conduit Crossing and Service Pipe

Note: See ADAC xml file for full attribute information


SEE SHEET 2

A1

REV NO	DATE	REVISION PURPOSE / DESCRIPTION	DRAWN	RPEQ	RPEQ No	INITIALS	DATE
A	23.11.23	Builders Issue					


DRAWN	CM	17.10.2023
CHECKED	-	-
APPROVED		


SH saunders havill group
 Saunders Havill Group Pty Ltd ABN 24 144 592 540
 head office 9 Thompson St Bowen Hills Q 4006
 phone: 090 453 5142 web: www.saundershavill.com
 ■ surveying ■ town planning ■ urban design ■ environmental management ■ landscape architecture

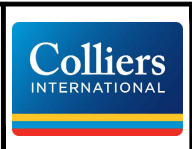

TILLERMAN - STAGE 2
PARK RIDGE ROAD, PARK RIDGE
PLAN OF ADAC SURVEY DATA
WATER RETICULATION OW/223/2022

DRAWING STATUS AS CONSTRUCTED	
SHEET 1 OF 3 SHEETS	
DRAWING NO.	REV. A

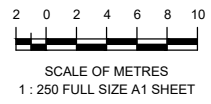

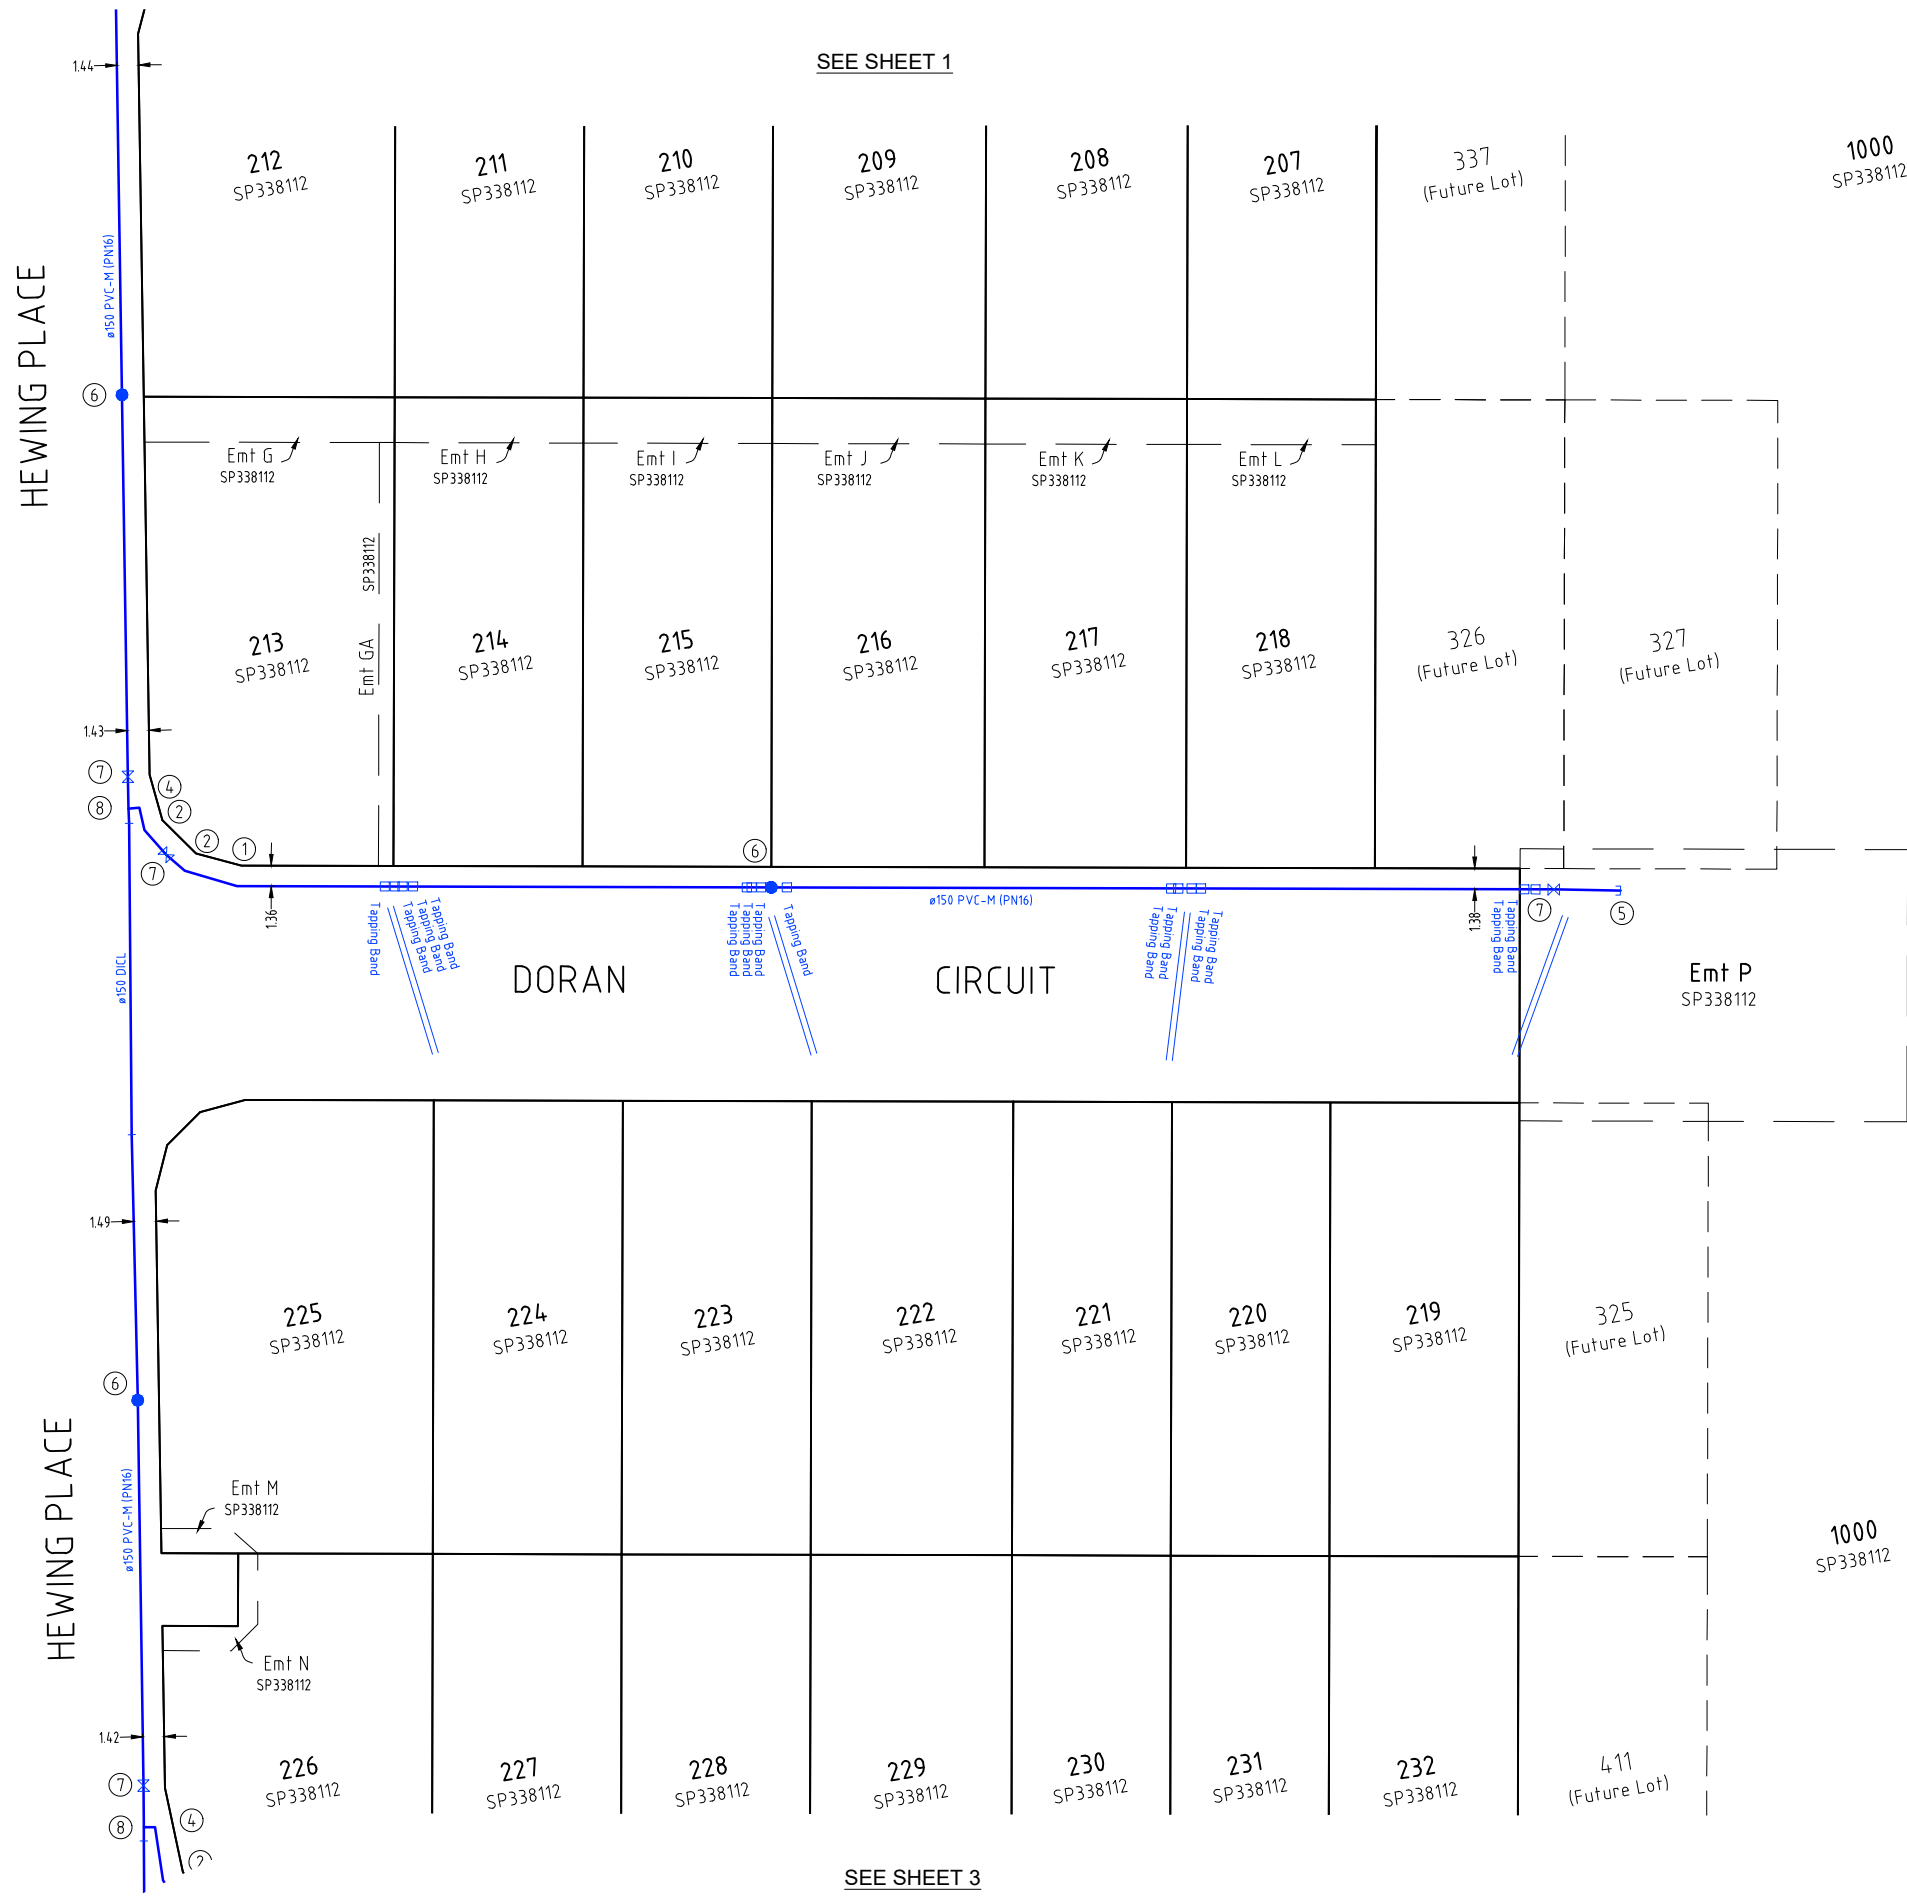

2
RP137533


SCHEDULE OF FITTINGS

①	φ150 11.25° Bend
②	φ150 22.5° Bend
③	φ150 45° Bend
④	φ150 90° Bend
⑤	φ150 Dead End Cap
⑥	φ150 Hydrant
⑦	φ150 Valve
⑧	φ150 x φ150 Tee

WATER FITTINGS LEGEND

	Hydrant
	Valve
	Bend
	Water Fitting
	Dead End Cap
	Reducer
	Water Meter
	Conduit Crossing and Service Pipe

Note: See ADAC xml file for full attribute information

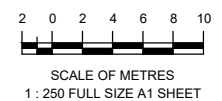


A1

REV NO	DATE	REVISION PURPOSE / DESCRIPTION	DRAWN	RPEQ	RPEQ No
A	23.11.23	Builders Issue			

DRAWN	CM	17.10.2023
CHECKED	-	-
APPROVED		

SH saunders havill group
 Saunders Havill Group Pty Ltd ABN 24 144 592 540
 head office 9 Thompson St Bowen Hills Q 4006
 phone 0900 633 5146 web www.saundershavill.com
 ■ surveying ■ town planning ■ urban design ■ environmental management ■ landscape architecture

Drawing No: 10652 S 27 AC A

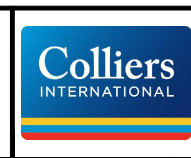

TILLERMAN - STAGE 2
PARK RIDGE ROAD, PARK RIDGE
PLAN OF ADAC SURVEY DATA
WATER RETICULATION OW/223/2022

DRAWING STATUS AS CONSTRUCTED	
SHEET 2 OF 3 SHEETS	
DRAWING NO.	REV. A

