

TILLERMAN

PARK RIDGE

PROPOSED RESIDENTIAL DEVELOPMENT

STAGE 7 OPERATIONAL WORKS

133-159 PARK RIDGE ROAD, PARK RIDGE

FOR 'HB PARK RIDGE'



DRAWING LIST

EARTHWORKS, ROADWORKS AND DRAINAGE

- 22-0448-100 COVER PLAN
- 22-0448-101 GENERAL NOTES
- 22-0448-102 BULK EARTHWORKS LAYOUT PLAN
- 22-0448-103 BULK EARTHWORKS TYPICAL SECTIONS SHEET 1 OF 2
- 22-0448-104 BULK EARTHWORKS TYPICAL SECTIONS SHEET 2 OF 2
- 22-0448-105 ROADWORKS AND DRAINAGE LAYOUT PLAN
- 22-0448-106 SURVEY SETOUT AND KERB TYPES LAYOUT PLAN
- 22-0448-107 REDCOMB DRIVE LONGITUDINAL SECTION AND CROSS SECTIONS
- 22-0448-108 WALKER STREET LONGITUDINAL SECTION
- 22-0448-109 WALKER STREET CROSS SECTIONS
- 22-0448-110 MANGO DRIVE LONGITUDINAL SECTION AND CROSS SECTIONS
- 22-0448-111 AIRFIELD STREET LONGITUDINAL SECTION AND CROSS SECTIONS
- 22-0448-112 INTERSECTION DETAILS LAYOUT PLAN
- 22-0448-113 SIGNS AND LINEMARKING LAYOUT PLAN
- 22-0448-114 STORMWATER DRAINAGE CATCHMENT LAYOUT PLAN
- 22-0448-115 STORMWATER DRAINAGE LONGITUDINAL SECTIONS SHEET 1 OF 3
- 22-0448-116 STORMWATER DRAINAGE LONGITUDINAL SECTIONS SHEET 2 OF 3
- 22-0448-117 STORMWATER DRAINAGE LONGITUDINAL SECTIONS SHEET 3 OF 3
- 22-0448-118 STORMWATER DRAINAGE CALCULATIONS TABLE

SEWERAGE AND WATER RETICULATION

- 22-0448-300 SEWERAGE AND WATER RETICULATION COVER PLAN
- 22-0448-301 SEWERAGE AND WATER RETICULATION GENERAL NOTES
- 22-0448-302 SEWERAGE AND WATER RETICULATION LIVE WORKS DETAILS
- 22-0448-303 SEWERAGE LAYOUT PLAN
- 22-0448-304 SEWERAGE LONGITUDINAL SECTIONS
- 22-0448-305 WATER RETICULATION LAYOUT PLAN
- 22-0448-306 FIRE HYDRANT REACH LAYOUT PLAN

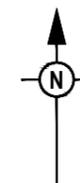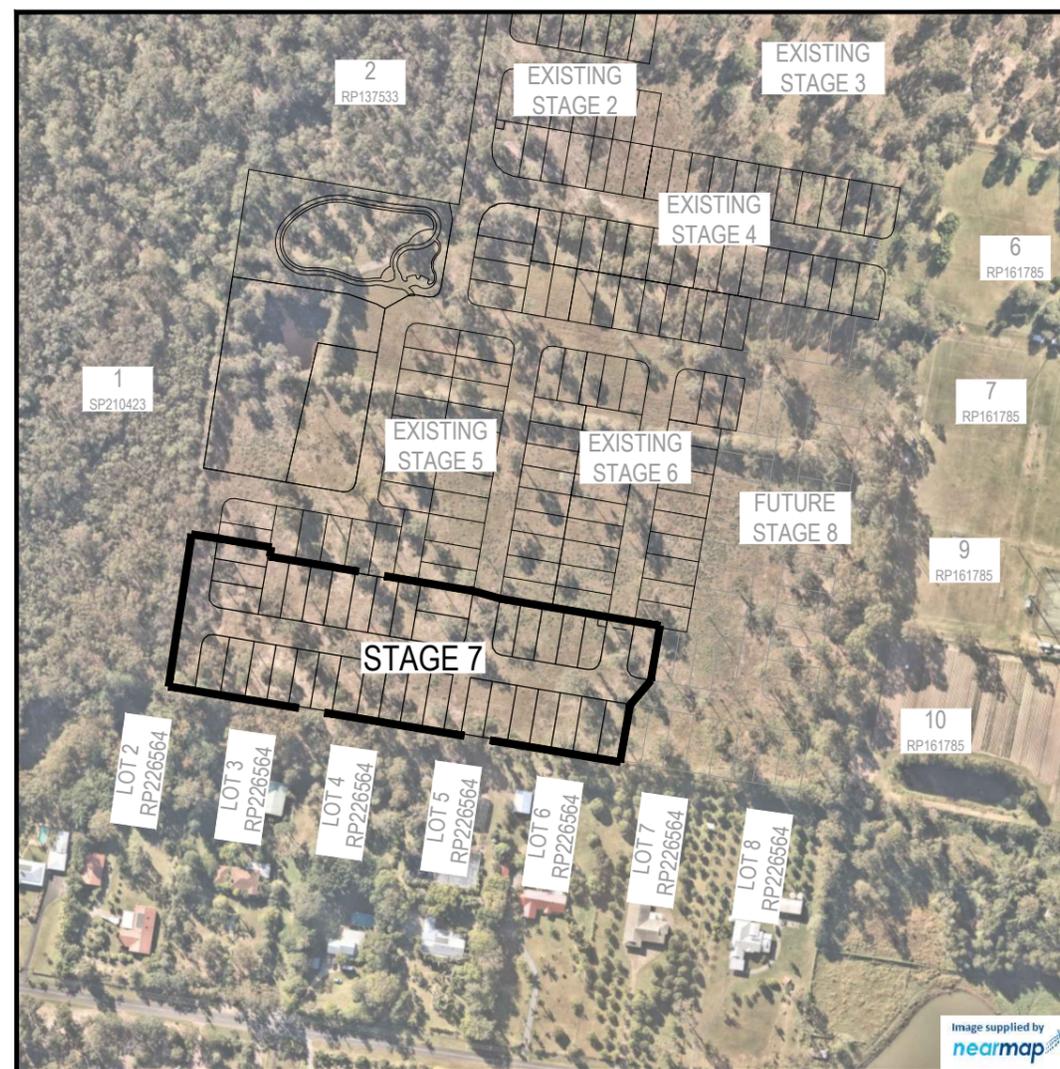

| | |
|---------------------------------------|--|
| PROJECT INFORMATION SUMMARY: | |
| STAGE 7 WORKS | |
| No. OF LOTS = 36 | |
| AREA OF STAGE 7 SITE = 2.10 ha | |
| RP DESCRIPTION | |
| LOT 3 ON RP137533 | |
| LOCAL AUTHORITY: LOGAN CITY COUNCIL | |
| COUNCIL REFERENCE NUMBER: COM/36/2021 | |


| |
|---|
| NOTE: |
| THESE DRAWINGS ARE TO BE READ IN CONJUNCTION WITH: |
| - VEGETATION MANAGEMENT PLAN |
| - LANDSCAPE ARCHITECT'S PLANS |
| - ELECTRICAL, COMMUNICATIONS AND GAS CONSULTANT'S PLANS |
| - SEDIMENT AND EROSION REPORT |
| - SAFETY IN DESIGN REPORT |
| - COLLIER'S STANDARD DRAWINGS FOR BRIDGING STRUCTURE |
| - 22-0447 - STAGE 6 ENGINEERING DRAWINGS |
| - 22-0447 - STAGE 6 TO 8 BULK EARTHWORKS DRAWINGS |
| - 22-0446 - STAGE 5 ENGINEERING DRAWINGS |

| | |
|--|-------------------------------|
| ENGINEER'S CERTIFICATION | |
| I, Daniel Collins, hereby certify that: | |
| As Constructed information shown on this plan is a true and correct record of the sizes, types, materials, classes etc., and it corresponds with the relevant approved Engineering Drawings. | |
| | |
| RPEQ (signature) | RPEQ No. 18631 Date: 17/03/25 |

LOCALITY PLAN
SCALE 1:2000 (A1)
SCALE 1:4000 (A3)

| | | | | | | | | | | | |
|-----|----------|--------|-------|-------------------------|------------------|-------|-----------------------|--|--|--|-------------------------------|
| REV | DATE | DESIGN | DRAWN | ISSUED FOR CONSTRUCTION | REVISION DETAILS | DRAWN | STATUS | SCALE | CLIENT | PROJECT NAME | DRAWING TITLE |
| 0 | 26.08.24 | CL | AK | AS CONSTRUCTED | | | AS CONSTRUCTED | 1:2000 20 0 20 40 60 80 100 A1 1:4000 | | | COVER PLAN |
| 1 | 17.03.25 | CL | BP | AS CONSTRUCTED | | | | | ASSOCIATED CONSULTANT SAUNDERS HAVILL GROUP PH: 1300 123 744 | STAGE 7 133-159 PARK RIDGE ROAD, PARK RIDGE | PROJECT No. 22-0448 |
| | | | | | | | | | | | DRAWING No. 100 |
| | | | | | | | | | | | REVISION 1 |

FOR AND ON BEHALF OF COLLIER'S INTERNATIONAL ENGINEERING & DESIGN PTY LTD

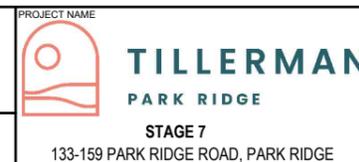

| | | |
|----------------|-------------|----------|
| PROJECT No. | DRAWING No. | REVISION |
| 22-0448 | 100 | 1 |

GENERAL NOTES:

1. THE CONTRACTOR SHALL SUPPLY ALL LABOR, MATERIALS, PLANT AND EQUIPMENT TO CONSTRUCT THE WORKS AS DOCUMENTED AND STRICTLY IN ACCORDANCE WITH THE RELEVANT AUTHORITY STANDARDS, SPECIFICATIONS AND REQUIREMENTS.
2. THE EXISTING SERVICES THAT ARE SHOWN ON THE DRAWINGS ARE PROVIDED FOR INFORMATION PURPOSES ONLY. NO RESPONSIBILITY IS TAKEN BY THE SUPERINTENDENT OR THE PRINCIPAL FOR INFORMATION THAT HAS BEEN SUPPLIED BY OTHERS, OR ANY EXISTING SERVICES THAT MAY BE PRESENT NOT SHOWN ON THE DRAWINGS. THE CONTRACTOR SHALL VERIFY THE POSITION OF ANY UNDERGROUND SERVICES WITHIN THE AREAS OF WORKS AND SHALL BE RESPONSIBLE FOR MAKING GOOD ANY DAMAGE THERETO. ANY ALTERATION WORKS TO SERVICES WILL BE CARRIED OUT ONLY BY THE SERVICE OWNER AUTHORITY UNLESS APPROVED OTHERWISE.
3. ALL CONSTRUCTION ACTIVITIES UNDERTAKEN SHALL COMPLY WITH CURRENT WORKPLACE HEALTH AND SAFETY REQUIREMENTS AND LEGISLATION.
4. PRIOR TO COMMENCING WORK, THE CONTRACTOR IS RESPONSIBLE FOR OBTAINING ALL RELEVANT LOCAL AUTHORITY PERMITS.
5. THE CONTRACTOR SHALL NOT COMMENCE THE DEMOLITION OF ANY EXISTING BUILDINGS AND/OR STRUCTURES WITHOUT APPROVAL FROM THE SUPERINTENDENT.
6. THE CONTRACTOR SHALL APPLY INDUSTRY BEST PRACTICE SO WORKS SHALL NOT DISTURB OR AFFECT NEARBY RESIDENTS EITHER BY DUST, NOISE, FLOODING OR DISCONNECTION OF SERVICES. CONTRACTOR TO ENSURE THAT ACCESS AND SERVICES TO EXISTING PROPERTIES ARE AVAILABLE AT ALL TIMES.
7. THE CONTRACTOR SHALL VERIFY LEVELS OF EXISTING SERVICE CROSSINGS AND CONNECTION POINTS PRIOR TO COMMENCEMENT OF WORKS AND NOTIFY SUPERINTENDENT OF ANY DISCREPANCIES BETWEEN ACTUAL AND PROPOSED DESIGN LEVELS.
8. THESE ENGINEERING DRAWINGS ARE TO BE READ IN CONJUNCTION WITH THE APPROVED VEGETATION MANAGEMENT PLAN, WHERE APPLICABLE. WHEN IN DOUBT, ALL EXISTING TREES ARE TO REMAIN UNLESS DIRECTED OTHERWISE.
9. **HOLD POINT:** ONCE THE BASE OF MANHOLES, INSPECTION PITS, GULLIES AND FIELD INLETS FOR STORMWATER DRAINAGE AND SEWER RETICULATION HAVE BEEN POURED, CONSTRUCTION SHALL ONLY RE-COMMENCE ONCE THE SUPERINTENDENT AND/OR ENGINEER HAVE INSPECTED THE WORKS.
10. THE CONTRACTOR SHALL NOTE DURING THE COURSE OF THE WORKS WHEN JOINT INSPECTIONS WITH THE AUTHORITY AND THE SUPERINTENDENT ARE REQUIRED. THESE INCLUDE PRE-STARTS, SUBGRADES, PRE-SEALS, CLEARING, AND OTHER SUCH INSPECTIONS AS NOMINATED IN THE APPROVAL AND THE SPECIFICATIONS. THE CONTRACTOR SHALL ENSURE NO WORKS PROCEED PAST THE INSPECTION POINT UNTIL THE JOINT INSPECTION HAS BEEN SUCCESSFULLY COMPLETED.
11. THE CONTRACTOR SHALL BE RESPONSIBLE FOR PROVIDING A SAFE MOVEMENT OF TRAFFIC AND THE PROTECTION OF PERSON AND PROPERTY THROUGH AND AROUND THE SITE. THE CONTRACTOR IS RESPONSIBLE FOR ALL TRAFFIC MANAGEMENT INCLUDING THE DESIGN, CONSTRUCTION, MAINTENANCE AND REMOVAL OF TEMPORARY ROADWAYS, DETOURS, SIGNS, LIGHTS AND BARRIER AS REQUIRED STRICTLY IN ACCORDANCE WITH THE RELEVANT AUTHORITY REQUIREMENTS.

BULK EARTHWORKS NOTES

1. NOTWITHSTANDING THE EXTENTS OF CUTTING AND FILLING SHOWN ON DRAWINGS, THE SUPERINTENDENT RESERVES THE RIGHT TO ADJUST THE FINISHED SURFACE LEVELS AND EARTHWORKS EXTENTS THROUGH WRITTEN DIRECTION.
2. THE CONTRACTOR SHALL UNDERTAKE ALL CLEARING USING INDUSTRY BEST PRACTICE INCLUDING CONSIDERATION OF FAUNA RELOCATION.
3. THE CONTRACTOR SHALL UNDERTAKE ALL EARTHWORKS IN ACCORDANCE WITH AS3798-2007 AND LOCAL AUTHORITY REQUIREMENTS. LEVEL 1 SUPERVISION IS REQUIRED.
4. THE CONTRACTOR SHALL CONSIDER LOADS GENERATED BY THE EARTHWORKS OPERATIONS SO AS TO AVOID DAMAGE TO ALL PIPES, SERVICES AND STRUCTURES.
5. THE EARTHWORKS DRAWINGS ARE TO BE READ IN CONJUNCTION WITH THE PROJECT'S SEDIMENT AND EROSION CONTROL PLAN, WHERE APPLICABLE.
6. THE CONTRACTOR SHALL BE RESPONSIBLE FOR THE PLANNING, DESIGN, CERTIFICATION, IMPLEMENTATION AND MAINTENANCE OF AN EROSION AND SEDIMENT CONTROL PLAN THAT IS COMPLIANT WITH THE INTERNATIONAL EROSION CONTROL ASSOCIATION (IECA) GUIDELINE 'BEST PRACTICE EROSION AND SEDIMENT CONTROL' AND RELEVANT COUNCIL POLICIES.
7. ALLOTMENT FINISHED SURFACE LEVELS, SHOWN ON THE LAYOUT PLAN, INDICATE THE FINISHED SURFACE LEVEL AFTER TOPSOIL PLACEMENT.

ROADWORKS AND DRAINAGE NOTES

1. ALL WORKS SHALL BE IN ACCORDANCE WITH THE RELEVANT AUTHORITY'S STANDARD DRAWINGS, METHODS AND SPECIFICATIONS.
2. NOTWITHSTANDING THE EXTENTS OF CUTTING AND FILLING SHOWN ON DRAWINGS, THE SUPERINTENDENT RESERVES THE RIGHT TO ADJUST THE FINISHED SURFACE LEVELS AND EARTHWORKS EXTENTS THROUGH WRITTEN DIRECTION.
3. NEW CONSTRUCTION SHALL BE NEATLY JOINED TO EXISTING FORMATION. WHERE REQUIRED, THE EXISTING FORMATION SHALL BE SAW CUT IN ACCORDANCE WITH IPWEAQ STD DRG RS-170. LEVELS AND GRADIENTS AT CONNECTIONS WITH EXISTING WORKS MAY BE VARIED AS REQUIRED TO ACHIEVE A SMOOTH CONNECTION.
4. THE CONTRACTOR SHALL UNDERTAKE ALL EARTHWORKS IN ACCORDANCE WITH AS3798-2007 AND LOCAL AUTHORITY REQUIREMENTS. LEVEL 1 SUPERVISION IS REQUIRED.
5. THE CONTRACTOR SHALL SUPPLY THE SUPERINTENDENT WITH THE SUBGRADE TEST RESULTS NECESSARY FOR ALL PAVEMENT DESIGN.
6. THE CONTRACTOR SHALL ENSURE A MINIMUM OF 75mm TOPSOIL TO ALL VERGE AND BATTER AREAS (AND STABILISATION AS ORDERED)
7. THE CONTRACTOR SHALL INSTALL ALL FOOTPATH AND PRAM RAMPS IN COMPLIANCE WITH THE AUTHORITY'S STANDARD DRAWINGS. PRAM RAMPS ARE TO BE LOCATED CLEAR OF DRAINAGE GULLY PITS AND FUTURE DRIVEWAY POSITIONS INDICATED ON THE LAYOUT PLANS.
8. THE CONTRACTOR SHALL INSTALL SUBSOIL DRAINS UNDER ALL KERBS AS REQUIRED BY THE LOCAL AUTHORITY'S STANDARDS.
9. THE CONTRACTOR SHALL ENSURE THAT ALL RETAINING WALL SUBSOIL DRAINS ARE TO CONNECT TO EITHER KERB ADAPTORS, STORMWATER DRAINAGE STRUCTURES OR KERB SUBSOIL DRAINS. CONTRACTOR TO DEMONSTRATE TO SUPERINTENDENT THAT SUITABLE CONNECTIONS HAVE BEEN PROVIDED FOR ALL WALLS.
10. ALL STORMWATER DRAINAGE MATERIALS, BEDDING, JOINTING AND STEP IRON REQUIREMENTS SHALL BE IN ACCORDANCE WITH THE RELEVANT AUTHORITIES STANDARD DRAWINGS, METHODS AND SPECIFICATIONS.
11. THE STORMWATER PIPE CLASSES HAVE BEEN DESIGNED FOR SERVICE LOADS ONLY. THE CONTRACTOR SHALL ASSESS THE SUITABILITY OF MACHINERY USED ON SITE AND THE ANTICIPATED CONSTRUCTION LOADS, AND UPGRADE THE PIPE CLASSES IF NECESSARY IN ACCORDANCE WITH AS3725-2007.
12. THE TERM D₅₀ DOCUMENTED ON THE DRAWINGS, IN RELATION TO ROCK ARMORING, CORRESPONDS TO THE REQUIRED MEDIAN DIAMETER OF THE PLACED ROCKS. THE ROCKS USED SHALL NOT VARY IN SIZE BY +/- 30% OF THE PROPOSED D₅₀ SIZE.

ROOFWATER NOTES

1. THE GEOMETRIC CENTRE SHALL BE TAKEN AS THE SETOUT POINT FOR ALL STRUCTURES, UNLESS DETAILED OTHERWISE.
2. ROOFWATER ALIGNMENT, COVER, MATERIALS, BEDDING, JOINTING AND STEP IRON REQUIREMENTS SHALL BE IN ACCORDANCE WITH THE RELEVANT AUTHORITY'S STANDARD DRAWINGS, METHODS AND SPECIFICATIONS.
3. ALL PVC PIPES ARE TO BE MINIMUM CLASS SN8.
4. END CAPS SHALL BE INSTALLED ON ENDS OF ALL PIPES AND STUBS.
5. WHERE ROOFWATER PIPES ARE ALIGNED BEHIND PROPOSED RETAINING WALLS, THE CONTRACTOR IS TO REFER TO THE SPECIFIC PROJECT DESIGN DETAILS AND CONFIRM CLEARANCES WITH THE SUPERINTENDENT PRIOR TO LAYING OF THE PIPES.
6. PROPERTY CONNECTIONS SHALL BE 1500 UNLESS SHOWN OTHERWISE. THE CONTRACTOR SHALL EXTEND CONNECTIONS A MINIMUM OF 1.0m BEYOND ADJACENT SEWER LINES, WHERE APPLICABLE.
7. IN INSTANCES WHERE REAR ALLOTMENT DRAINAGE IS NOT PROVIDED, THE CONTRACTOR SHALL INSTALL A ROOFWATER CONNECTION TO EACH PROPERTY BY ONE OF THE FOLLOWING METHODS, AS SHOWN ON THE LAYOUT PLAN:
 - TWO ROOFWATER KERB ADAPTOR 500mm FROM THE DOWNSTREAM BOUNDARY (UNLESS SHOWN ON A DIFFERENT ALIGNMENT). WHERE THERE IS A CONCRETE FOOTPATH, A ROOFWATER PIPE SHALL BE INSTALLED FROM THE PROPERTY BOUNDARY CONNECTED TO THE KERB ADAPTOR AT 1.25% MINIMUM GRADE IN ACCORDANCE WITH COUNCIL'S STANDARDS.
 - ONE 1500 ROOFWATER PIPE CONNECTED TO PROPOSED STORMWATER GULLY PIT OR MANHOLE AT MINIMUM 1.0% GRADE WITH 1.0m COVER.


ENGINEER'S CERTIFICATION

I, Daniel Collins, hereby certify that:
As Constructed information shown on this plan is a true and correct record of the sizes, types, materials, classes etc., and it corresponds with the relevant approved Engineering Drawings.



RPEQ (signature) RPEQ No. 18631 Date: 17/03/25

| REV | DATE | DESIGN | DRAWN | REVISION DETAILS | DRAWN | STATUS | SCALE | CLIENT | PROJECT NAME | DRAWING TITLE |
|-----|----------|--------|-------|-------------------------|---|-----------------------------------|---|---|---|-------------------------------|
| 0 | 26.08.24 | CL | AK | ISSUED FOR CONSTRUCTION | | AS CONSTRUCTED |  |  |  | GENERAL NOTES |
| 1 | 17.03.25 | CL | BP | AS CONSTRUCTED | | | | | | |
| | | | | | DESIGN | APPROVED DANIEL COLLINS | | ASSOCIATED CONSULTANT SAUNDERS HAVILL GROUP PH: 1300 123 744 | STAGE 7 133-159 PARK RIDGE ROAD, PARK RIDGE | PROJECT No. 22-0448 |
| | | | | | | RPEQ 18631 | | | | DRAWING No. 101 |
| | | | | | | DATE 17.03.25 | | | | REVISION 1 |
| | | | | | FOR AND ON BEHALF OF COLLIER'S INTERNATIONAL ENGINEERING & DESIGN PTY LTD | | | | | |

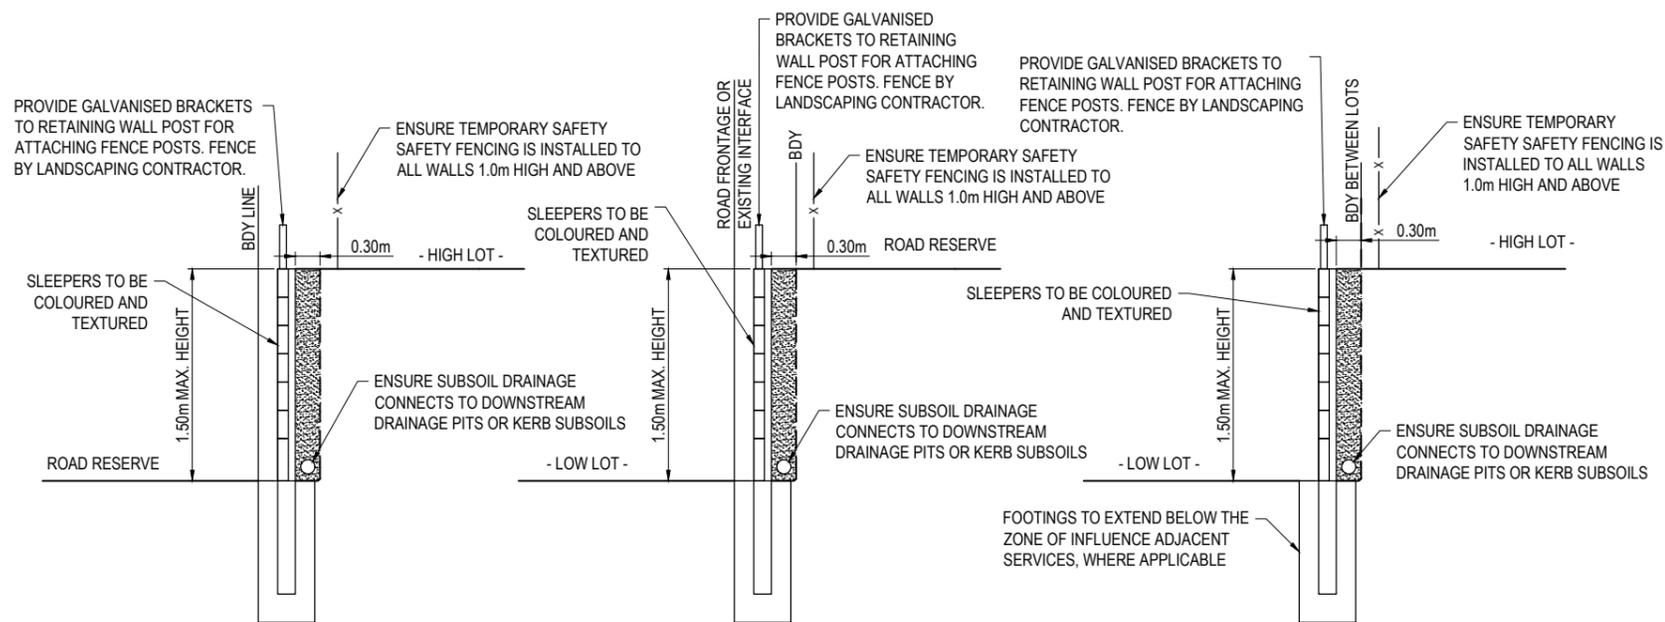

TYPICAL RETAINING DETAIL (HIGHER LOT FRONTING ROAD RESERVE OR EXISTING)
SCALE 1:50 (A1)
SCALE 1:100 (A3)

TYPICAL RETAINING DETAIL (LOWER LOT FRONTING ROAD RESERVE OR EXISTING)
SCALE 1:50 (A1)
SCALE 1:100 (A3)

TYPICAL RETAINING DETAIL (BETWEEN LOTS)
SCALE 1:50 (A1)
SCALE 1:100 (A3)

LEGEND

- PROPOSED AREA OF WORKS
- PROPOSED SURFACE CONTOUR
- EXISTING SURFACE CONTOUR
- PROPOSED EARTHWORKS PAD SETBACK LINE
- CONCRETE SLEEPER RETAINING WALL HEIGHT RANGE 0.50m-1.50m MAX
- CONCRETE SLEEPER RETAINING WALL (MIN. 0.200m RAISED ABOVE DESIGN)
- CONCRETE SLEEPER RETAINING WALL (MIN. 0.250m RAISED ABOVE DESIGN)
- EXISTING CONCRETE SLEEPER RETAINING WALL
- PROPOSED CUT-OFF DRAIN
- RETAINING WALL SUBSOIL PIPE EXTENSION
- PROPOSED FINISHED SURFACE LEVEL (FSL) (AFTER TOPSOIL PLACEMENT)
- FUTURE STAGE FINISHED
- EXISTING SURFACE LEVEL (ESL)
- PROPOSED AREA OF CUT
- PROPOSED AREA OF FILL
- INDICATIVE DRIVEWAY LOCATIONS
- ZERO LOT BOUNDARY
- EXISTING STORMWATER DRAINAGE PIPE
- EXISTING ROOFWATER DRAINAGE PIPE
- EXISTING SEWER MAIN
- EXISTING WATER MAIN
- EXISTING WATER CONDUIT
- EXISTING ELECTRICAL CABLE U/G
- EXISTING ELECTRICAL CABLE O/H
- EXISTING TELECOMMUNICATION CABLE U/G
- EXISTING FIBRE OPTIC CABLE U/G
- EXISTING GAS MAIN
- EXISTING DRAIN

EARTHWORKS VOLUMES

| | |
|---------|-------------------------------|
| CUT: | 6,704m ³ |
| FILL: | 1,317m ³ |
| EXPORT: | 5,386m ³ (SURPLUS) |


NOTE:
1. VOLUMES SHOWN ARE SOLID VALUES ONLY. NO ALLOWANCES FOR BULKING, COMPACTION, ROAD BOXING, UNSUITABLE MATERIALS.

WARNING! - EXISTING SERVICES

EXTREME CARE SHOULD BE TAKEN WHEN EXCAVATING IN THIS AREA. THE FOLLOWING EXISTING SERVICES ARE LIKELY TO BE PRESENT IN THE VICINITY OF THE SITE:

- ELECTRICAL CABLES
- TELECOMMUNICATIONS CABLES
- GAS MAINS
- WATER MAINS
- SEWER MAINS

THE CONTRACTOR SHOULD CONTACT THE SERVICE PROVIDER FOR FURTHER INFORMATION AND SATISFY THEMSELVES OF ANY SPECIFIC TREATMENT OR REQUIREMENTS.

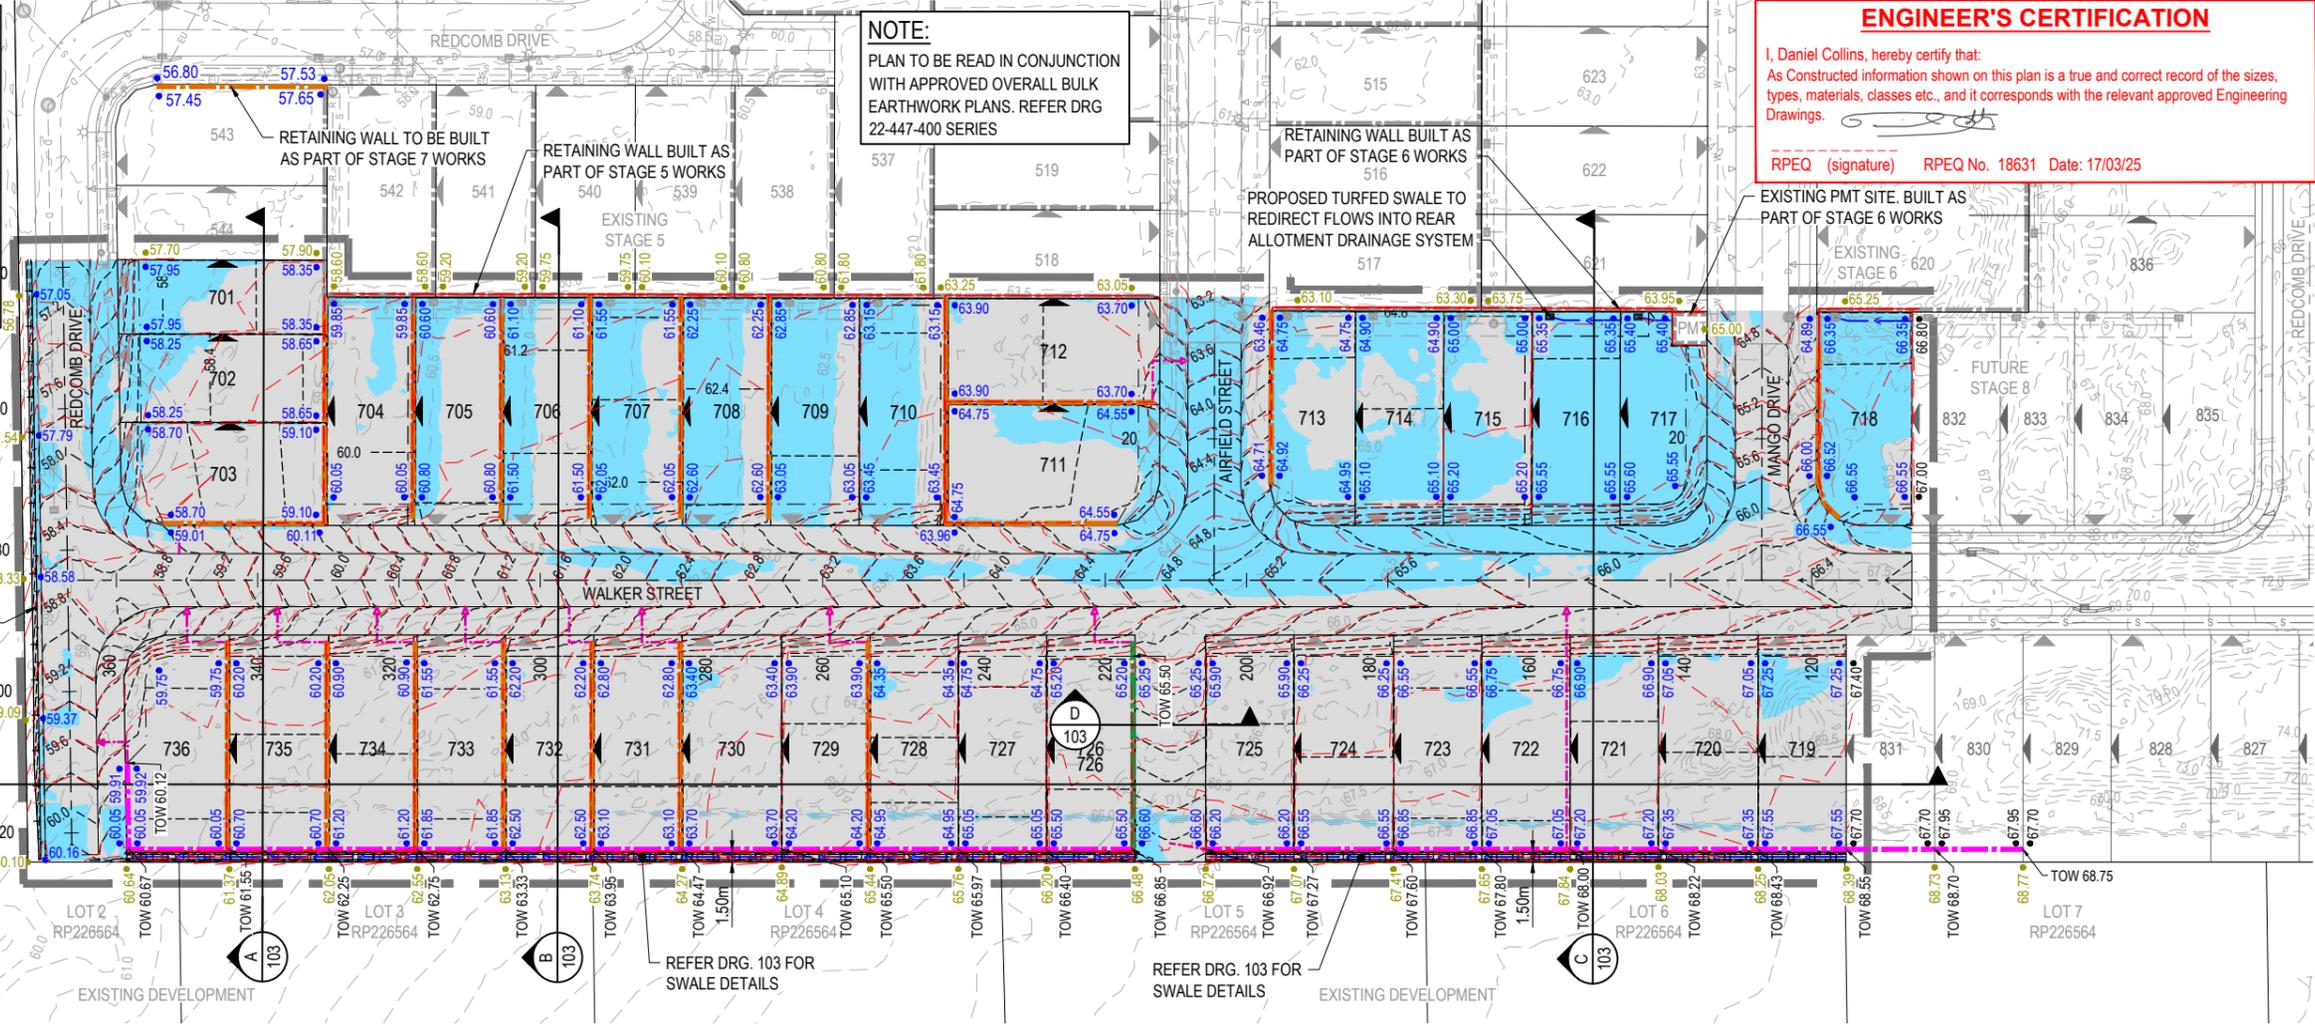


ASCEN LEGEND
AS CONSTRUCTED CONTOUR

ENGINEER'S CERTIFICATION


I, Daniel Collins, hereby certify that:
As Constructed information shown on this plan is a true and correct record of the sizes, types, materials, classes etc., and it corresponds with the relevant approved Engineering Drawings.

RPEQ (signature) RPEQ No. 18631 Date: 17/03/25


| | | | | | | | | | | | |
|---|----------|--------|-------|-------------------------|------------------|---|----------------|---------------------------------|---|--|-----------------------------|
| REV | DATE | DESIGN | DRAWN | ISSUED FOR CONSTRUCTION | REVISION DETAILS | DRAWN | STATUS | SCALE | CLIENT | PROJECT NAME | DRAWING TITLE |
| 0 | 26.08.24 | CL | AK | ISSUED FOR CONSTRUCTION | | | AS CONSTRUCTED | 1:500 10 5 0 10 20 A1 1:1000 | HB Land | TILLERMAN PARK RIDGE | BULK EARTHWORKS LAYOUT PLAN |
| 1 | 17.03.25 | CL | BP | AS CONSTRUCTED | | | | 1:50 1 0.5 0 1 2 A1 1:100 | SAUNDERS HAVILL GROUP PH: 1300 123 744 | STAGE 7 133-159 PARK RIDGE ROAD, PARK RIDGE | |
| DESIGN APPROVED DANIEL COLLINS RPEQ 18631 DATE 17.03.25 | | | | | | FOR AND ON BEHALF OF COLLIER'S INTERNATIONAL ENGINEERING & DESIGN PTY LTD | | | | PROJECT No. 22-0448 DRAWING No. 102 REVISION 1 | |

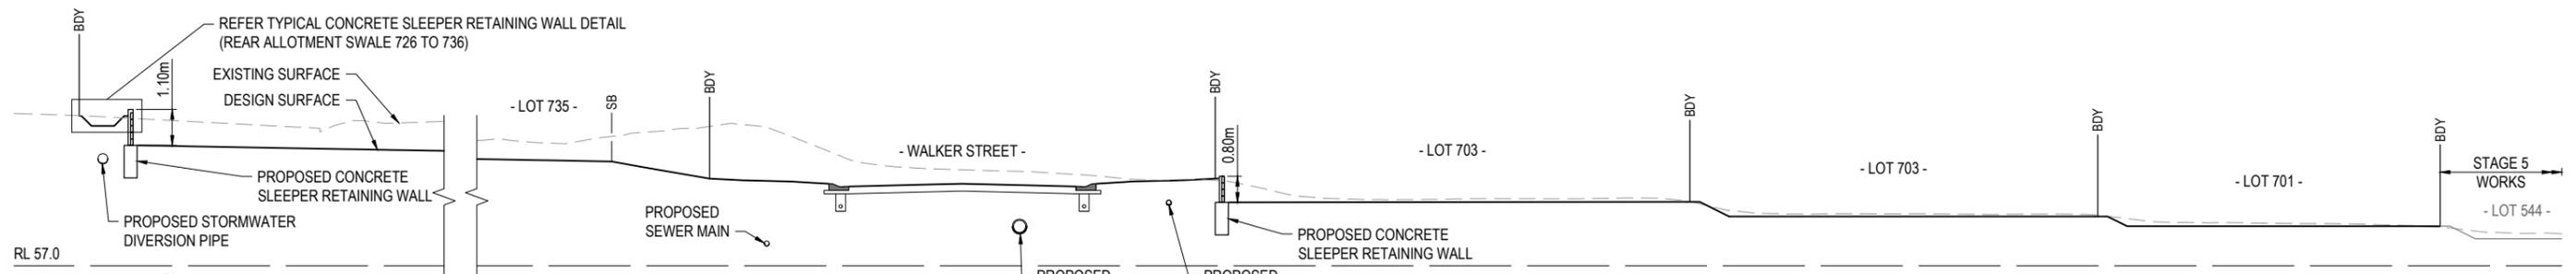


SECTION A
SCALE 1:100 (A1)
SCALE 1:200 (A3)

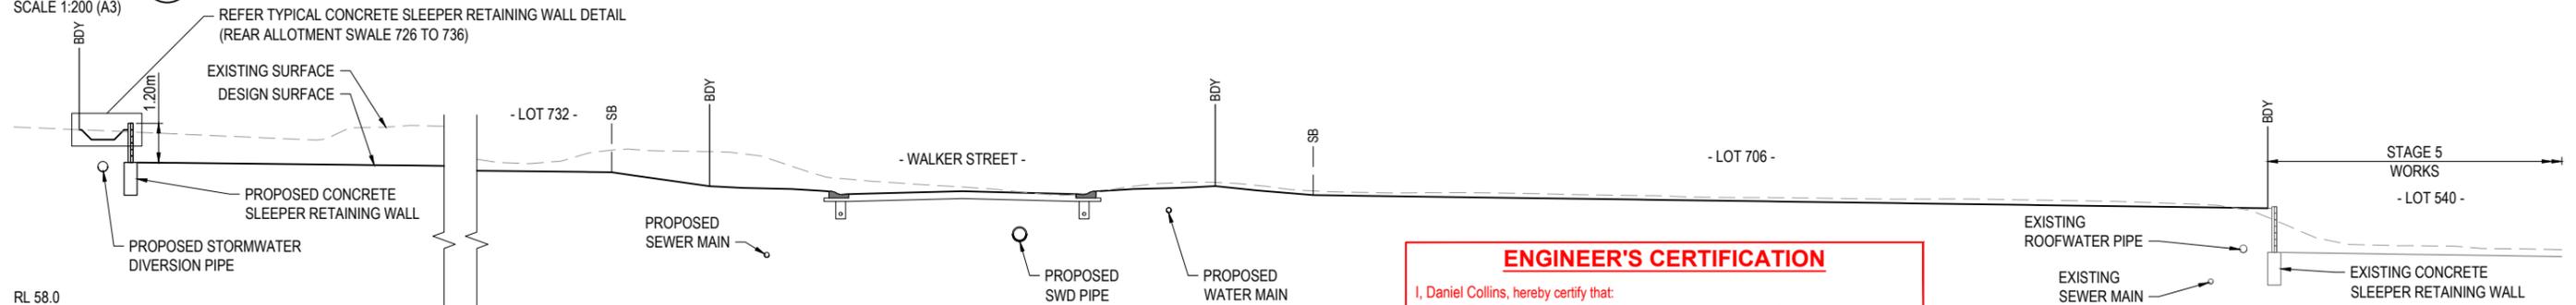

SECTION B
SCALE 1:100 (A1)
SCALE 1:200 (A3)

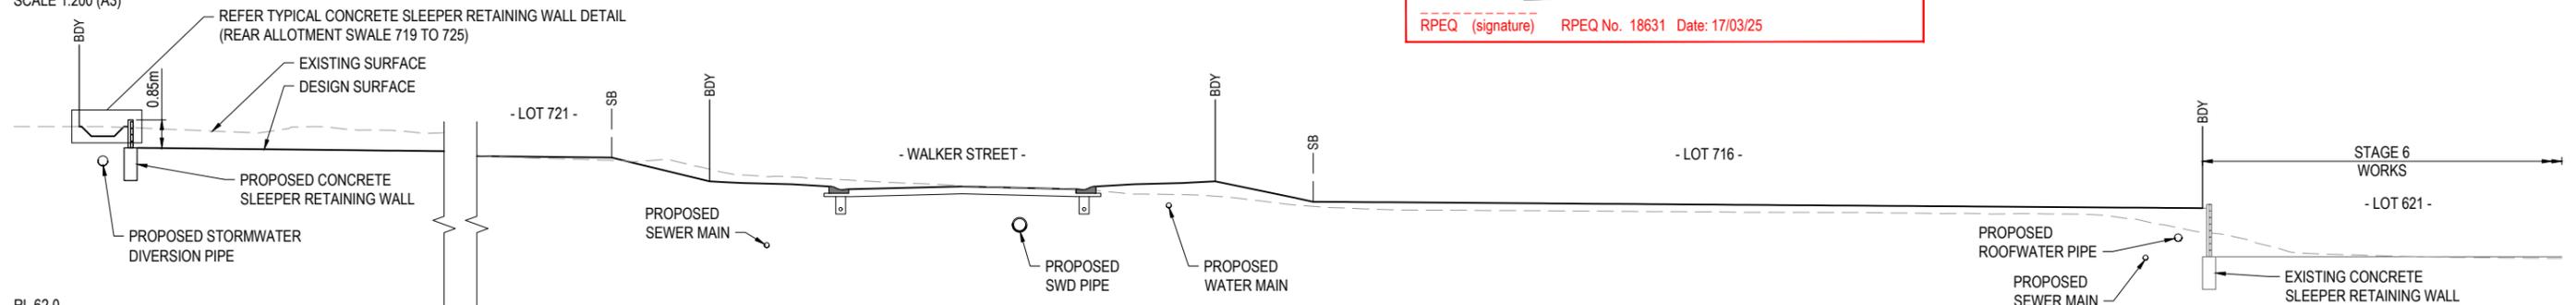


SECTION C
SCALE 1:100 (A1)
SCALE 1:200 (A3)

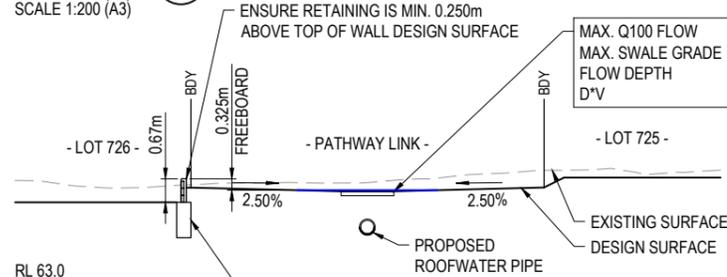


SECTION D
SCALE 1:100 (A1)
SCALE 1:200 (A3)

ENGINEER'S CERTIFICATION
I, Daniel Collins, hereby certify that:
As Constructed information shown on this plan is a true and correct record of the sizes, types, materials, classes etc., and it corresponds with the relevant approved Engineering Drawings.
RPEQ (signature) RPEQ No. 18631 Date: 17/03/25


- RETAINING WALL NOTES:**
- ALL RETAINING WALLS ARE TO BE DELIVERED UNDER DESIGN AND CONSTRUCTION ARRANGEMENT - FORMS 15 AND 12 CERTIFICATIONS ARE TO BE PROVIDED BY THE CONTRACTOR. DESIGN OF WALLS TO CONSIDER ALL LOADS (FENCES, DWELLINGS ETC) AS WELL AS ASSOCIATED IMPACTS FROM ANY ADJACENT SERVICES - FOOTING DEPTHS TO BE EXTENDED AS REQUIRED.
 - GEOTECHNICAL CONDITIONS ARE TO BE CONFIRMED AND APPROPRIATELY CONSIDERED FOR ALL WALLS.
 - REFER LANDSCAPE DRAWINGS FOR FURTHER INFORMATION ON RETAINING WALLS, PARTICULARLY RELATING TO FINISHES.
 - TEMPORARY SAFETY FENCING TO BE INSTALLED BEHIND ALL WALLS 1.0m HIGH AND GREATER.

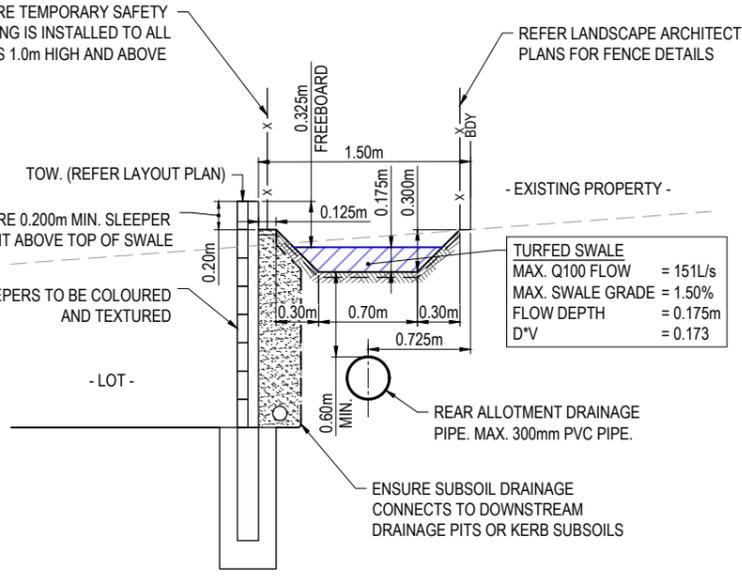

TYPICAL CONCRETE SLEEPER RETAINING WALL DETAIL
(REAR ALLOTMENT SWALE LOTS 719 TO 725)
SCALE 1:25 (A1)
SCALE 1:50 (A3)

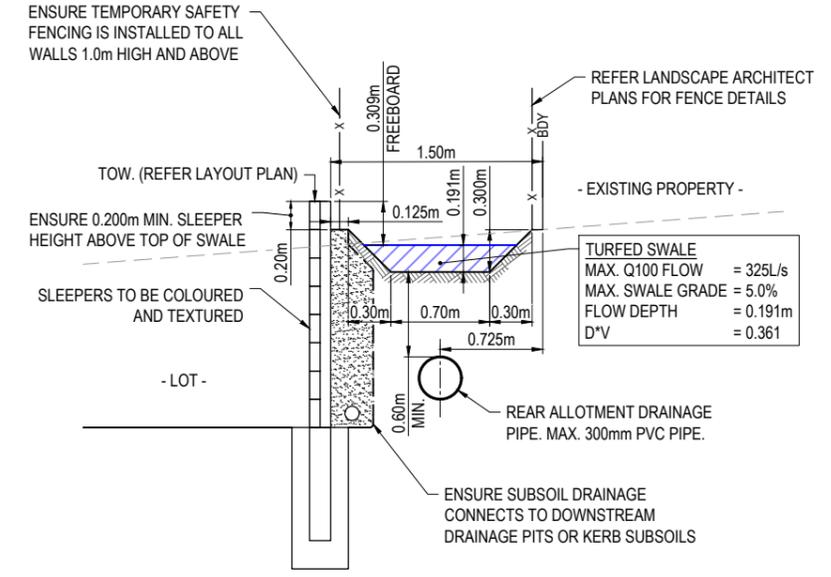

TYPICAL CONCRETE SLEEPER RETAINING WALL DETAIL
(REAR ALLOTMENT SWALE LOTS 726 TO 736)
SCALE 1:25 (A1)
SCALE 1:50 (A3)

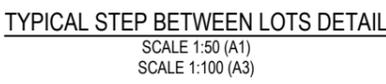

| REV | DATE | DESIGN | DRAWN | ISSUED FOR CONSTRUCTION | REVISION DETAILS |
|-----|----------|--------|-------|-------------------------|------------------|
| 0 | 26.08.24 | CL | AK | ISSUED FOR CONSTRUCTION | |
| 1 | 17.03.25 | CL | BP | AS CONSTRUCTED | |

| DRAWN | STATUS |
|----------------|--------|
| AS CONSTRUCTED | |




| SCALE | 1:100 | 1:200 | 1:25 | 1:50 |
|-------|----------------|-------|-----------------------------|-----------------------------|
| | 0 1 2 3 4 5 A1 | | 0 0.25 0.5 0.75 1.0 1.25 A1 | 0 0.25 0.5 0.75 1.0 1.25 A3 |


CLIENT
HB Land
ASSOCIATED CONSULTANT
SAUNDERS HAVILL GROUP
PH: 1300 123 744

PROJECT NAME
TILLERMAN PARK RIDGE
STAGE 7
133-159 PARK RIDGE ROAD, PARK RIDGE


| DRAWING TITLE | PROJECT No. | DRAWING No. | REVISION |
|---|-------------|-------------|----------|
| BULK EARTHWORKS TYPICAL SECTIONS SHEET 1 OF 2 | 22-0448 | 103 | 1 |

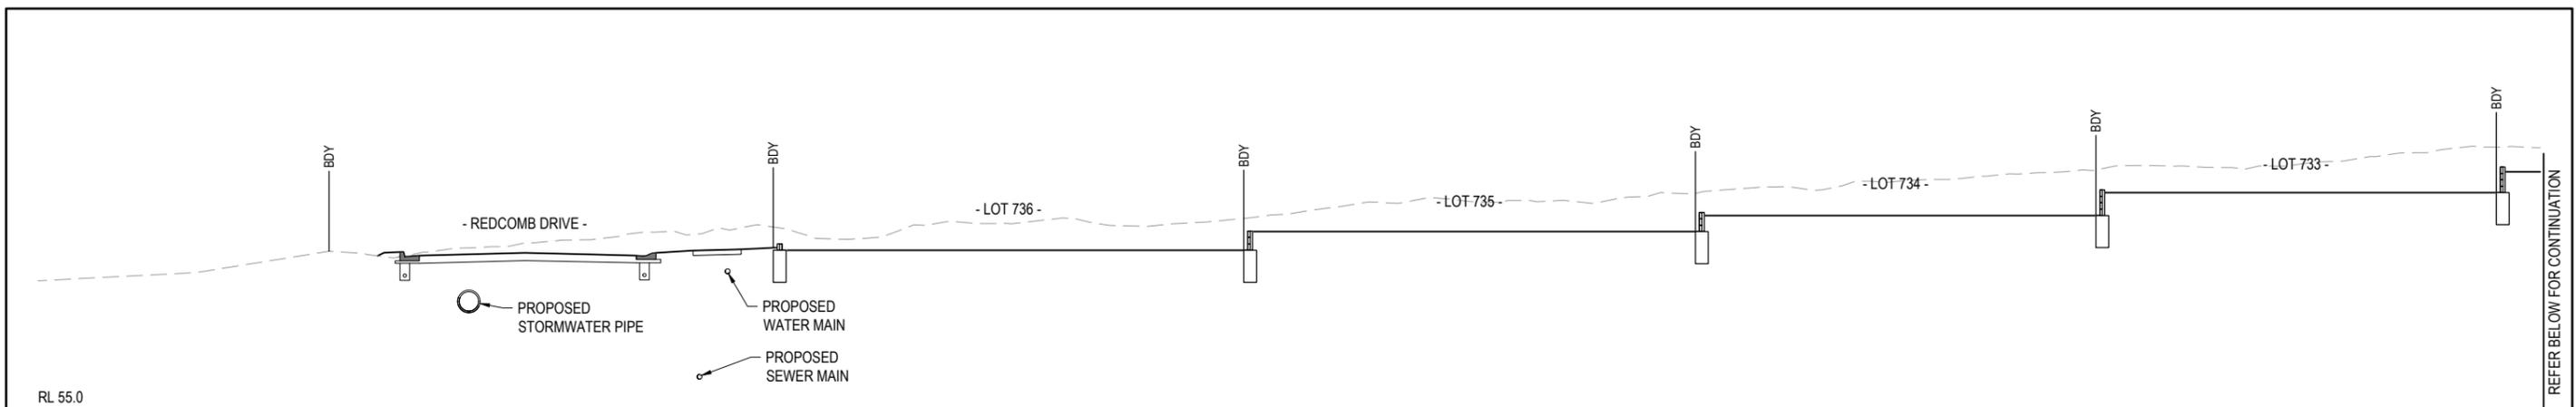


SECTION E
SCALE 1:100 (A1)
SCALE 1:200 (A3)

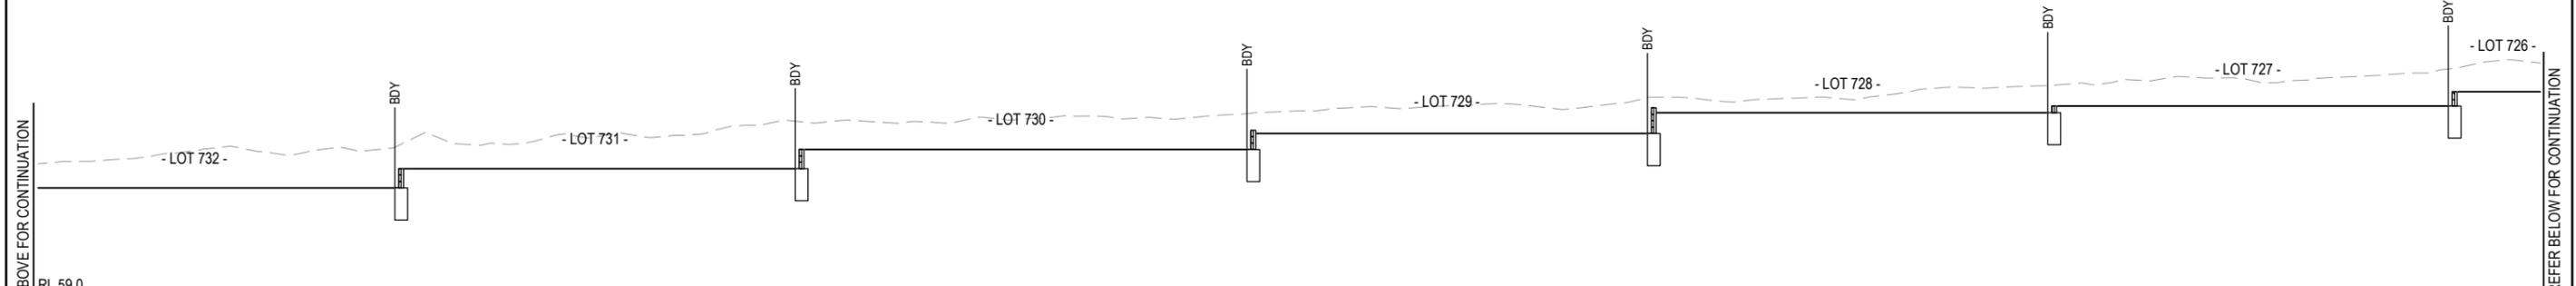

SECTION E
SCALE 1:100 (A1)
SCALE 1:200 (A3)

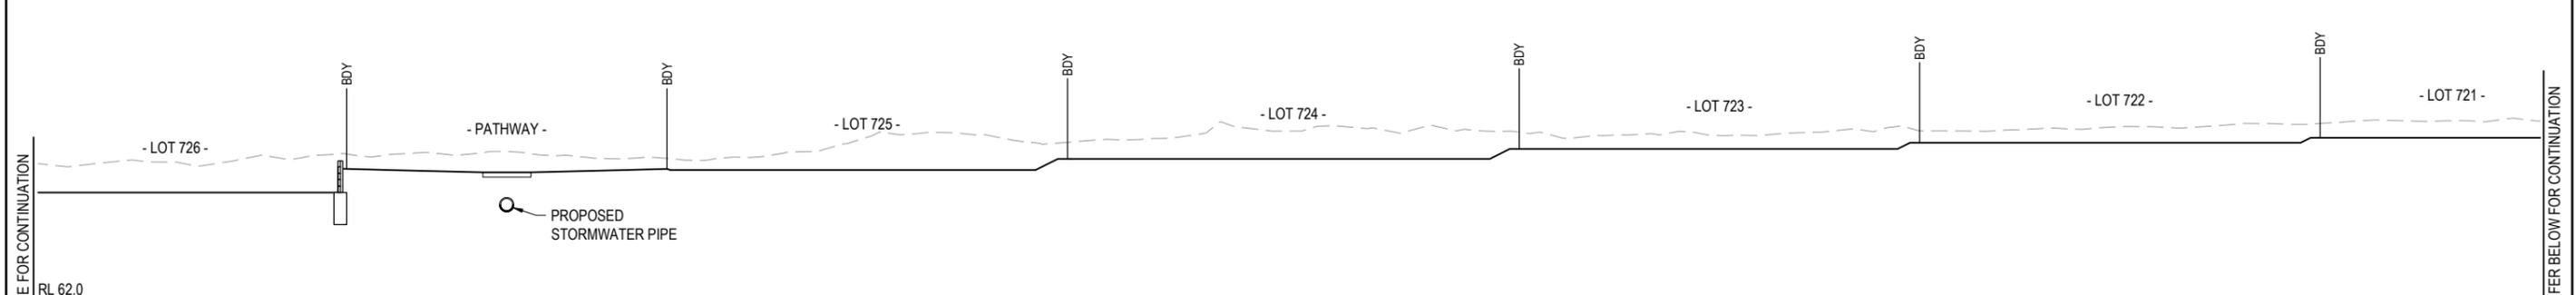

SECTION E
SCALE 1:100 (A1)
SCALE 1:200 (A3)

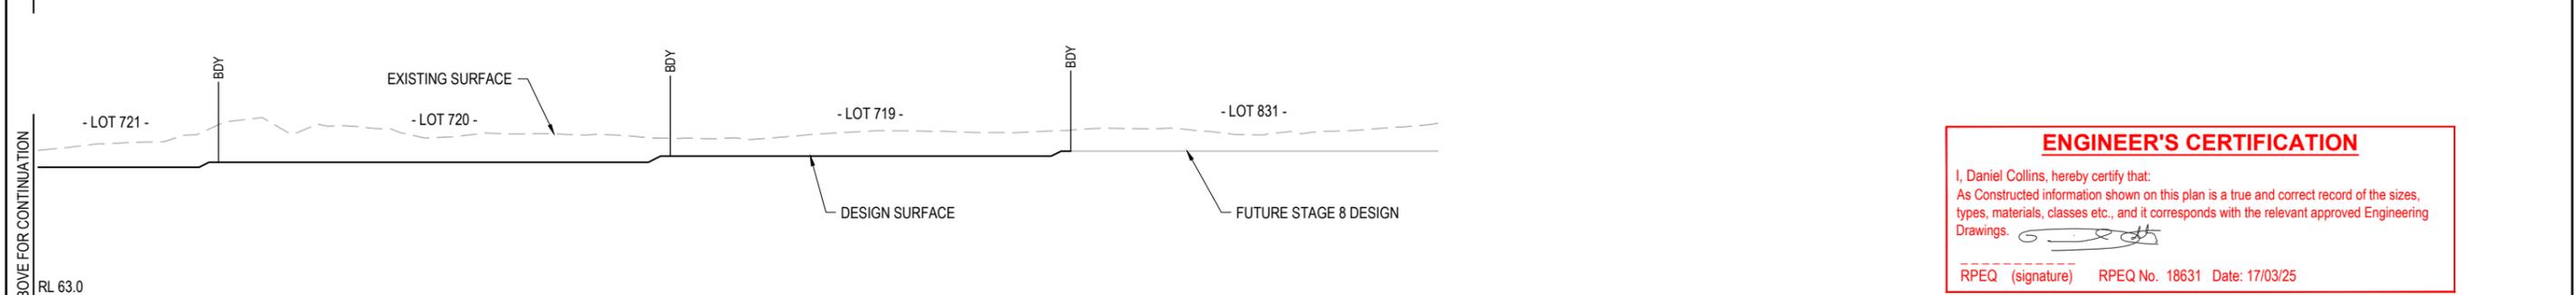


SECTION E
SCALE 1:100 (A1)
SCALE 1:200 (A3)

ENGINEER'S CERTIFICATION
I, Daniel Collins, hereby certify that:
As Constructed information shown on this plan is a true and correct record of the sizes, types, materials, classes etc., and it corresponds with the relevant approved Engineering Drawings.
[Signature]
RPEQ (signature) RPEQ No. 18631 Date: 17/03/25

| REV | DATE | DESIGN | DRAWN | REVISION DETAILS |
|-----|----------|--------|-------|-------------------------|
| 0 | 26.08.24 | CL | AK | ISSUED FOR CONSTRUCTION |
| 1 | 17.03.25 | CL | BP | AS CONSTRUCTED |

| DRAWN | STATUS | |
|--------|-----------------------|----------|
| | AS CONSTRUCTED | |
| DESIGN | APPROVED | DATE |
| | DANIEL COLLINS | 17.03.25 |
| | RPEQ 18631 | |

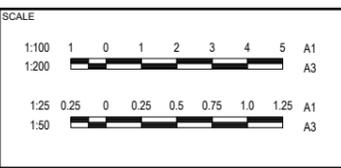


CLIENT

ASSOCIATED CONSULTANT
SAUNDERS HAVILL GROUP
PH: 1300 123 744

PROJECT NAME

STAGE 7
133-159 PARK RIDGE ROAD, PARK RIDGE

| DRAWING TITLE | | |
|--|-------------|----------|
| BULK EARTHWORKS TYPICAL SECTIONS SHEET 2 OF 2 | | |
| PROJECT No. | DRAWING No. | REVISION |
| 22-0448 | 104 | 1 |

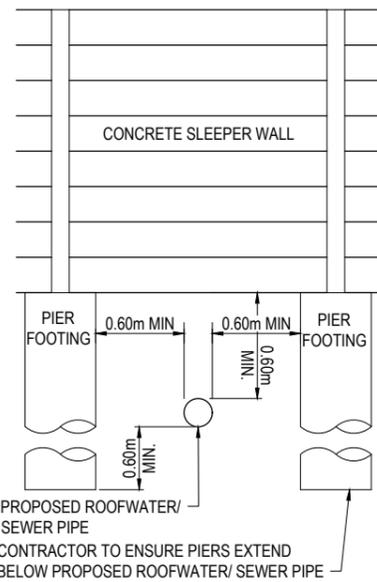

TYPICAL CONCRETE SLEEPER WALL OVER ROOFWATER OR SEWER DETAIL
N.T.S


ROOFWATER CONNECTION NOTE:

THE CONTRACTOR SHALL INSTALL ROOFWATER CONNECTIONS TO EACH PROPERTY BY ONE OF THE FOLLOWING METHODS, AS SHOWN ON THE LAYOUT PLAN:

METHOD 1:
ONE ROOFWATER KERB ADAPTOR 500mm FROM THE DOWNSTREAM BOUNDARY PLUS ONE ROOFWATER KERB ADAPTOR 6.0m FROM DOWNSTREAM BOUNDARY.

WHERE THERE IS A CONCRETE FOOTPATH, A ROOFWATER PIPE SHALL BE INSTALLED FROM THE PROPERTY BOUNDARY CONNECTED TO THE KERB ADAPTOR AT 1.25% MINIMUM GRADE.

METHOD 2:
ONE 150Ø ROOFWATER PIPE CONNECTED TO PROPOSED STORMWATER GULLY PIT OR MANHOLE AT MINIMUM 1.0% GRADE WITH 1.0m COVER.

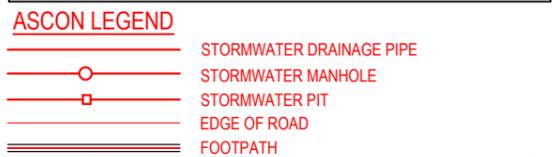

WARNING! - EXISTING SERVICES

EXTREME CARE SHOULD BE TAKEN WHEN EXCAVATING IN THIS AREA. THE FOLLOWING EXISTING SERVICES ARE LIKELY TO BE PRESENT IN THE VICINITY OF THE SITE:


- ELECTRICAL CABLES
- TELECOMMUNICATIONS CABLES
- GAS MAINS
- WATER MAINS
- SEWER MAINS

THE CONTRACTOR SHOULD CONTACT THE SERVICE PROVIDER FOR FURTHER INFORMATION AND SATISFY THEMSELVES OF ANY SPECIFIC TREATMENT OR REQUIREMENTS.


ENGINEER'S CERTIFICATION

I, Daniel Collins, hereby certify that:
As Constructed information shown on this plan is a true and correct record of the sizes, types, materials, classes etc., and it corresponds with the relevant approved Engineering Drawings.

(Signature)
RPEQ (signature) RPEQ No. 18631 Date: 17/03/25

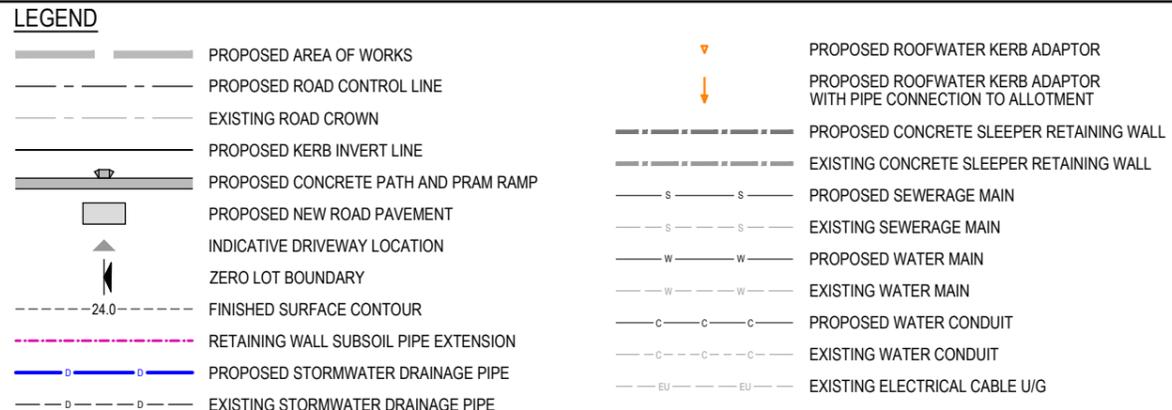

KERB TYPES NOTE:
REFER TO THE SURVEY SETOUT ENGINEERING DRAWING FOR KERB TYPES AND TRANSITION LOCATIONS

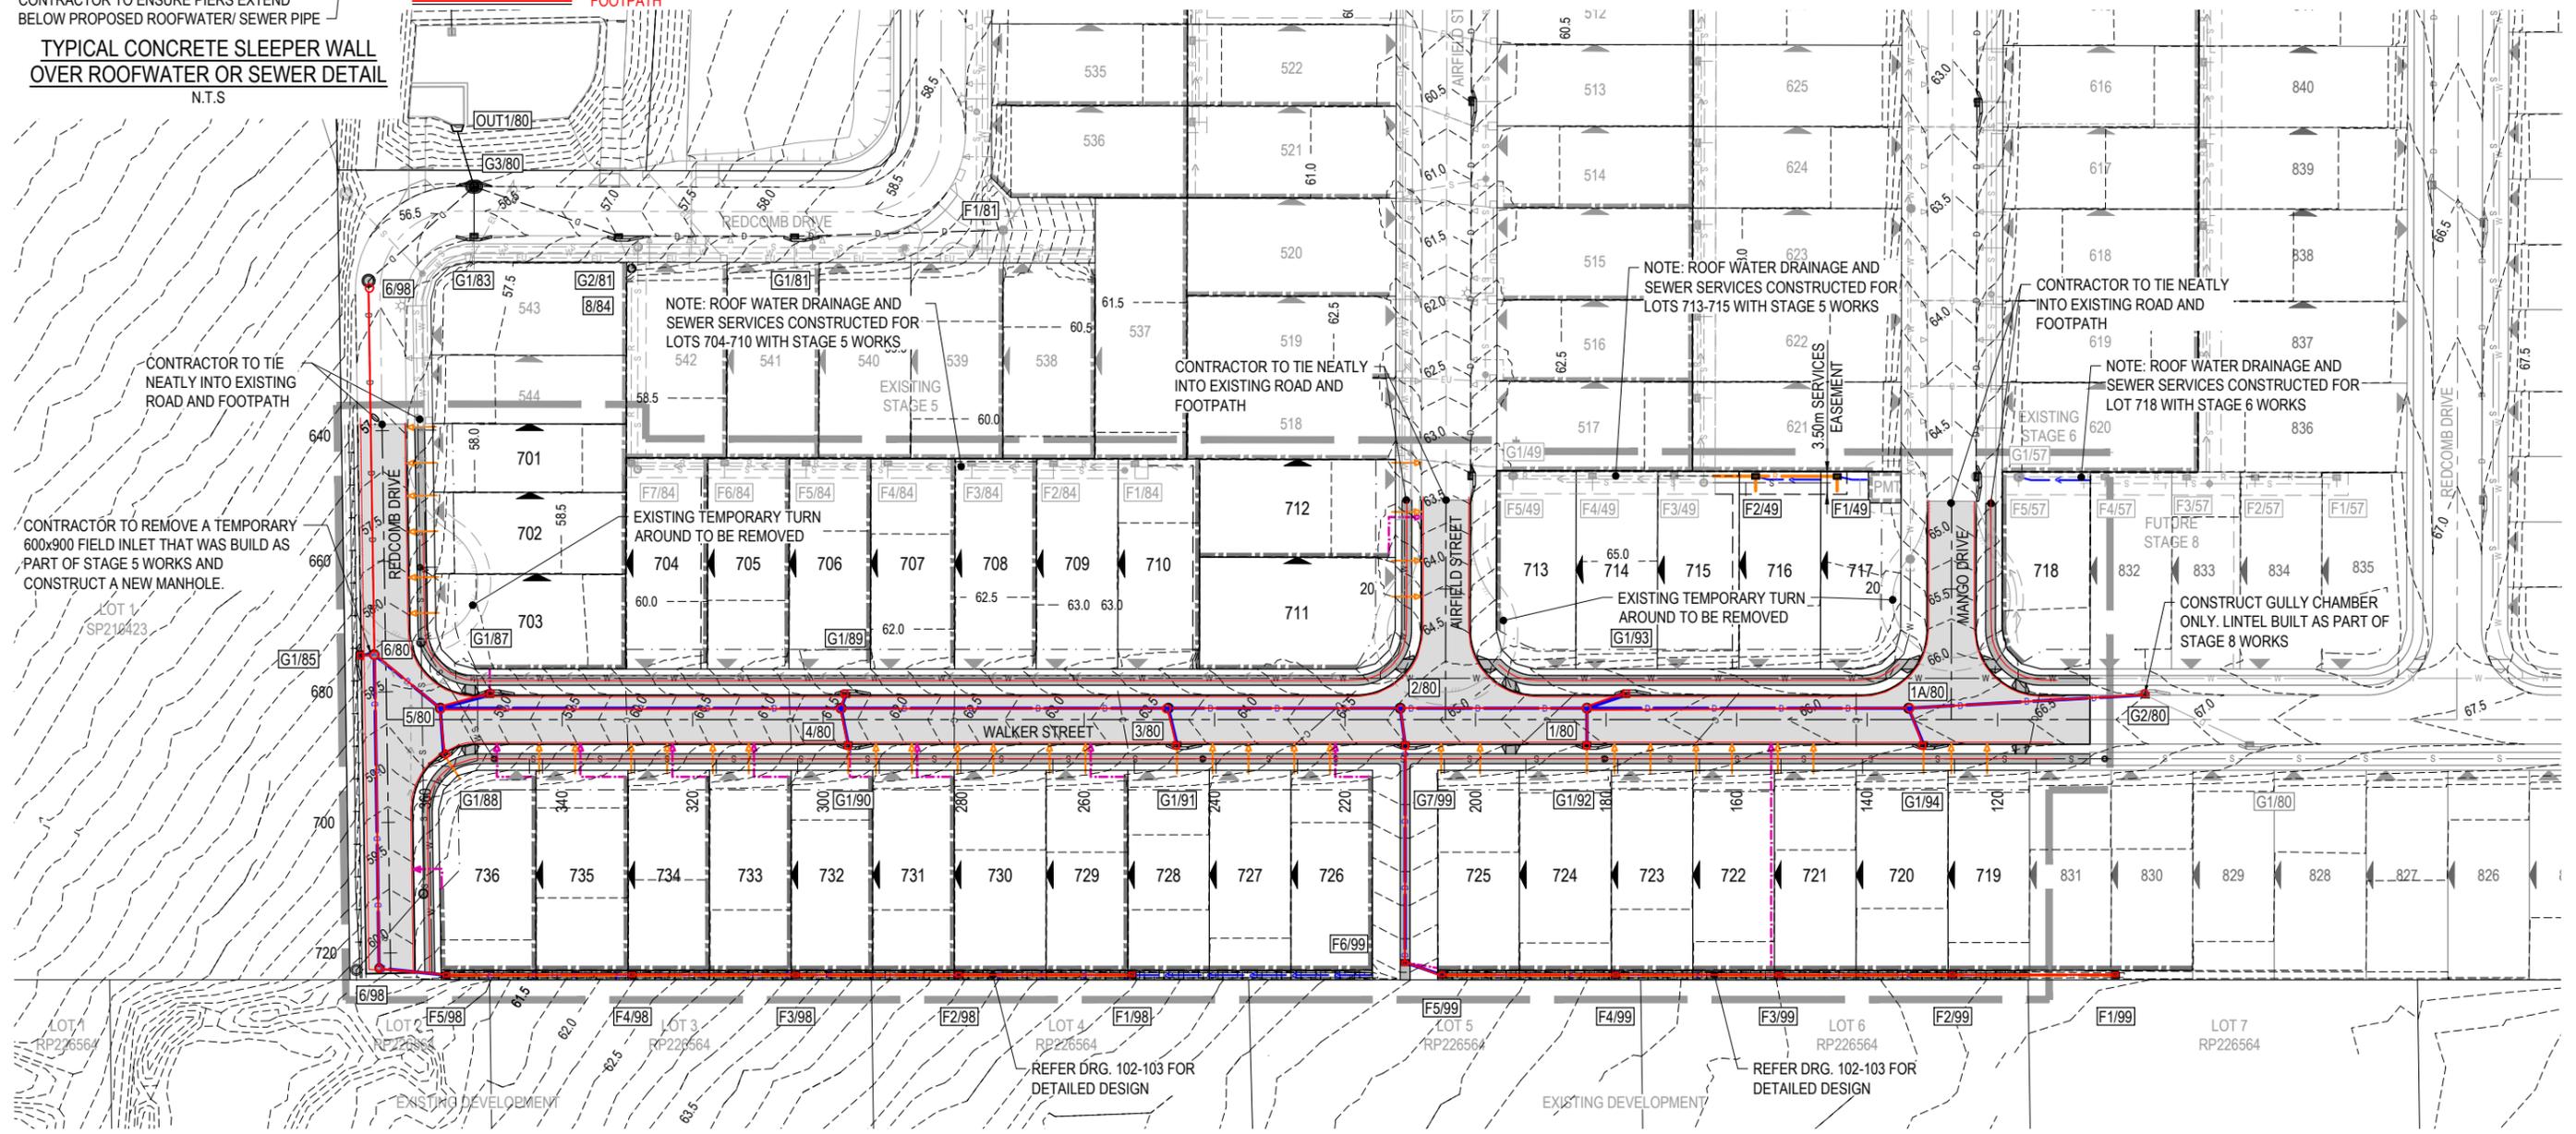

| | | | | | | | | | | | | |
|---|----------|--------|-------|-------------------------|------------------|-------|-----------------------|-----------------|--|---|---|--|
| REV | DATE | DESIGN | DRAWN | ISSUED FOR CONSTRUCTION | REVISION DETAILS | DRAWN | STATUS | SCALE | CLIENT | PROJECT NAME | DRAWING TITLE | |
| 0 | 26.08.24 | CL | AK | ISSUED FOR CONSTRUCTION | | | AS CONSTRUCTED | 1:500 1:1000 | HB Land | TILLERMAN PARK RIDGE | ROADWORKS AND DRAINAGE LAYOUT PLAN | |
| 1 | 17.03.25 | CL | BP | AS CONSTRUCTED | | | | | ASSOCIATED CONSULTANT SAUNDERS HAVILL GROUP PH: 1300 123 744 | STAGE 7 133-159 PARK RIDGE ROAD, PARK RIDGE | PROJECT No. 22-0448 DRAWING No. 105 REVISION 1 | |
| FOR AND ON BEHALF OF COLLIER'S INTERNATIONAL ENGINEERING & DESIGN PTY LTD | | | | | | | | | | | | |

CONTROL LINE SETOUT AIRFIELD STREET

| PT | CHAINAGE | EASTING | NORTHING | HEIGHT | BEARING |
|------|----------|------------|------------|--------|-------------|
| IP 1 | 0.000 | 505139.692 | 935373.758 | 64.939 | 9°38'00.23" |
| IP 2 | 192.775 | 505171.952 | 935563.814 | 59.697 | 9°38'00.23" |

CONTROL LINE SETOUT MANGO DRIVE


| PT | CHAINAGE | EASTING | NORTHING | HEIGHT | BEARING |
|------|----------|------------|------------|--------|-------------|
| IP 1 | 0.000 | 505216.126 | 935360.945 | 65.893 | 9°38'00.23" |
| IP 2 | 192.617 | 505248.359 | 935550.845 | 62.563 | 9°38'00.23" |

CONTROL LINE SETOUT WALKER STREET

| PT | CHAINAGE | EASTING | NORTHING | HEIGHT | BEARING |
|------|----------|------------|------------|--------|---------------|
| IP 1 | 0.000 | 505341.487 | 935339.929 | 68.080 | 279°31'00.15" |
| IP 2 | 366.886 | 504979.650 | 935400.588 | 58.723 | 279°31'00.15" |

CONTROL LINE SETOUT REDCOMB DRIVE

| PT | CHAINAGE | EASTING | NORTHING | HEIGHT | BEARING | RAD/SPIRAL | A.LENGTH | DEFL.ANGLE |
|------|----------|------------|------------|--------|---------------|-------------|----------|--------------|
| IP 1 | 0.000 | 505292.559 | 935348.131 | | 9°38'00.23" | | | |
| TC | 182.459 | 505323.092 | 935528.017 | 64.545 | 9°38'00.23" | | | |
| IP 2 | 190.313 | 505324.766 | 935537.876 | 64.439 | | R = -10.000 | 15.708 | 90°00'00.00" |
| CT | 198.167 | 505314.907 | 935539.550 | 64.334 | 279°38'00.23" | | | |
| TC | 408.667 | 505107.375 | 935574.775 | 57.331 | 279°38'00.23" | | | |
| IP 3 | 418.092 | 505095.544 | 935576.783 | 57.143 | | R = -12.000 | 18.850 | 90°00'00.00" |
| CT | 427.516 | 505093.536 | 935564.953 | 57.059 | 189°38'00.23" | | | |
| TC | 518.716 | 505078.275 | 935475.039 | 58.607 | 189°38'00.23" | | | |
| IP 4 | 528.141 | 505076.266 | 935463.208 | 58.593 | | R = 12.000 | 18.850 | 90°00'00.00" |
| CT | 537.566 | 505064.436 | 935465.216 | 58.467 | 279°38'00.23" | | | |
| TC | 599.494 | 505003.381 | 935475.579 | 56.485 | 279°38'00.23" | | | |
| IP 5 | 609.024 | 504991.341 | 935477.623 | 56.581 | | R = -12.000 | 19.060 | 91°00'16.00" |
| CT | 618.554 | 504989.509 | 935465.549 | 56.715 | 188°37'44.23" | | | |
| IP 6 | 724.234 | 504973.653 | 935361.066 | | 188°37'44.23" | | | |

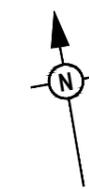

LEGEND

- PROPOSED AREA OF WORKS
- PROPOSED NEW ROAD PAVEMENT
- PROPOSED CONCRETE DRIVEWAY
- PROPOSED ROAD CONTROL LINE
- PROPOSED MOUNTABLE KERB AND CHANNEL 'TYPE M3'
- PROPOSED BARRIER KERB AND CHANNEL 'TYPE B1'
- PROPOSED EDGE OF RESTRAINT
- PROPOSED CONCRETE PATH (FINISHED AS PER LANDSCAPE ARCHITECT PLANS)
- INDICATIVE DRIVEWAY LOCATION
- ZERO LOT BOUNDARY


ASCON LEGEND

- EDGE OF ROAD
- FOOTPATH

ENGINEER'S CERTIFICATION

I, Daniel Collins, hereby certify that:
As Constructed information shown on this plan is a true and correct record of the sizes, types, materials, classes etc., and it corresponds with the relevant approved Engineering Drawings.

RPEQ (signature) RPEQ No. 18631 Date: 17/03/25

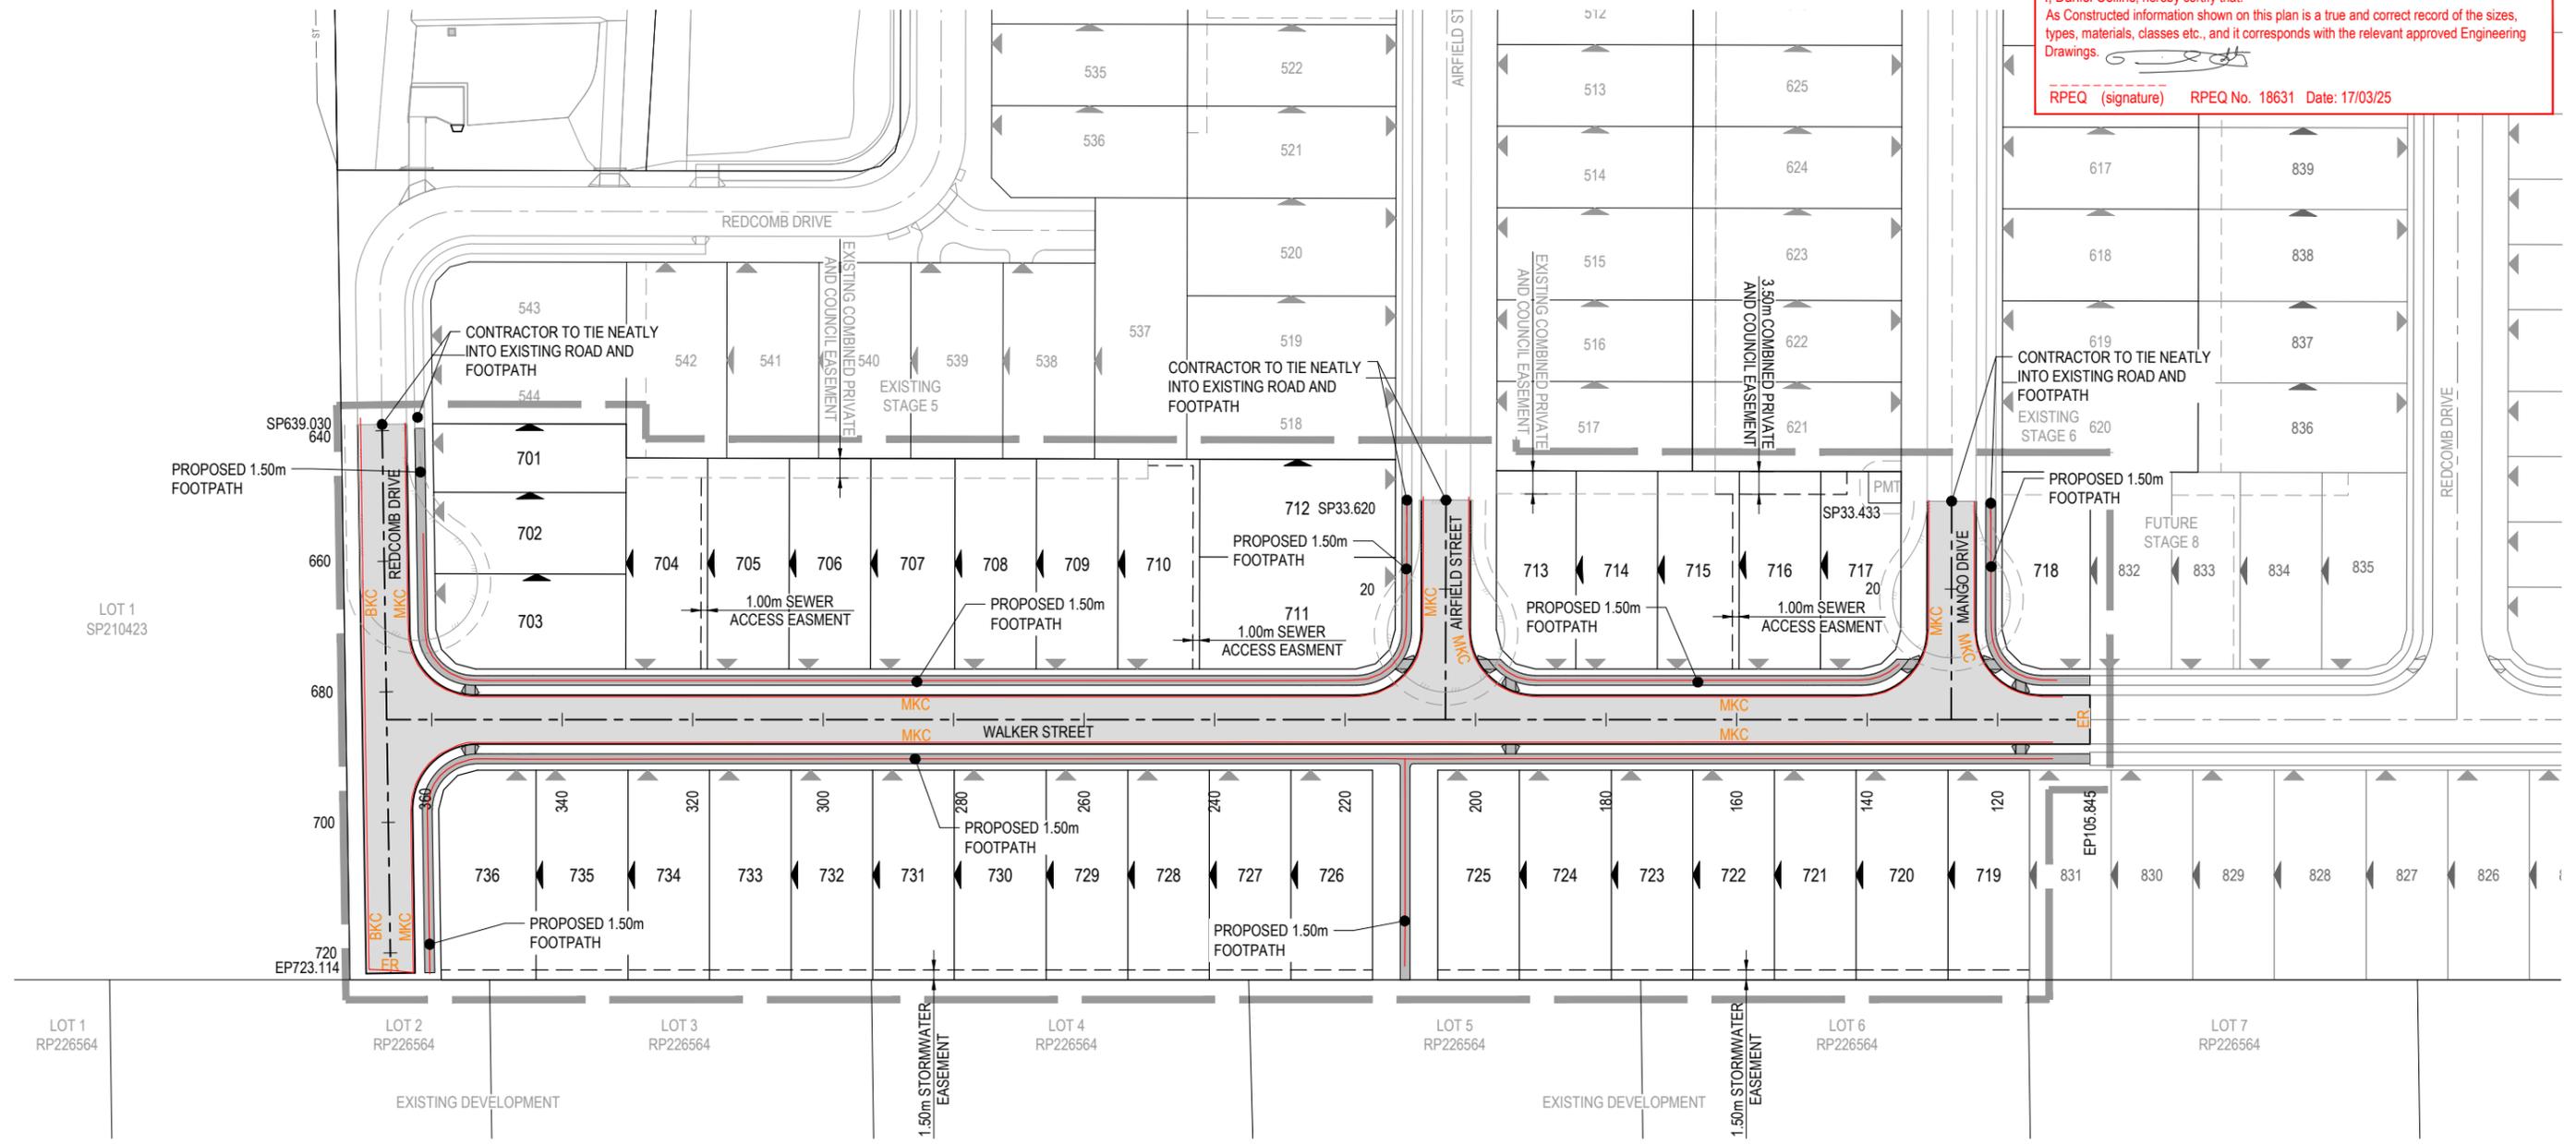


| <table border="1" style="width: 100%; border-collapse: collapse;"> <thead> <tr> <th>REV</th> <th>DATE</th> <th>DESIGN</th> <th>DRAWN</th> <th>REVISION DETAILS</th> </tr> </thead> <tbody> <tr> <td>0</td> <td>26.08.24</td> <td>CL</td> <td>AK</td> <td>ISSUED FOR CONSTRUCTION</td> </tr> <tr> <td>1</td> <td>17.03.25</td> <td>CL</td> <td>BP</td> <td>AS CONSTRUCTED</td> </tr> </tbody> </table> | REV | DATE | DESIGN | DRAWN | REVISION DETAILS | 0 | 26.08.24 | CL | AK | ISSUED FOR CONSTRUCTION | 1 | 17.03.25 | CL | BP | AS CONSTRUCTED | <table border="1" style="width: 100%; border-collapse: collapse;"> <thead> <tr> <th>DRAWN</th> <th>STATUS</th> </tr> </thead> <tbody> <tr> <td style="text-align: center;">AS CONSTRUCTED</td> <td></td> </tr> </tbody> </table> | DRAWN | STATUS | AS CONSTRUCTED | | | <p>SCALE</p> | <p>CLIENT</p> <p>ASSOCIATED CONSULTANT SAUNDERS HAVILL GROUP PH: 1300 123 744</p> | <p>PROJECT NAME</p> <p>STAGE 7 133-159 PARK RIDGE ROAD, PARK RIDGE</p> | <p>DRAWING TITLE</p> <p style="text-align: center;">SURVEY SETOUT AND KERB TYPES LAYOUT PLAN</p> <table border="1" style="width: 100%; border-collapse: collapse;"> <tr> <td>PROJECT No.</td> <td>DRAWING No.</td> <td>REVISION</td> </tr> <tr> <td style="text-align: center;">22-0448</td> <td style="text-align: center;">106</td> <td style="text-align: center;">1</td> </tr> </table> | PROJECT No. | DRAWING No. | REVISION | 22-0448 | 106 | 1 |
|---|-------------|----------|--------|-------------------------|------------------|---|----------|----|----|-------------------------|---|----------|----|----|----------------|---|-------|--------|-----------------------|--|--|--------------|---|--|--|-------------|-------------|----------|---------|-----|---|
| REV | DATE | DESIGN | DRAWN | REVISION DETAILS | | | | | | | | | | | | | | | | | | | | | | | | | | | |
| 0 | 26.08.24 | CL | AK | ISSUED FOR CONSTRUCTION | | | | | | | | | | | | | | | | | | | | | | | | | | | |
| 1 | 17.03.25 | CL | BP | AS CONSTRUCTED | | | | | | | | | | | | | | | | | | | | | | | | | | | |
| DRAWN | STATUS | | | | | | | | | | | | | | | | | | | | | | | | | | | | | | |
| AS CONSTRUCTED | | | | | | | | | | | | | | | | | | | | | | | | | | | | | | | |
| PROJECT No. | DRAWING No. | REVISION | | | | | | | | | | | | | | | | | | | | | | | | | | | | | |
| 22-0448 | 106 | 1 | | | | | | | | | | | | | | | | | | | | | | | | | | | | | |

ASSUMED PAVEMENT DETAILS (SUBJECT TO CBR TESTING)

| ROAD | ROAD CLASSIFICATION | DESIGN ESAs | ASSUMED CBR | SURFACING | BASE | SUB BASE | LOWER SUB BASE | TOTAL DEPTH |
|---------------|---------------------|-----------------------|-------------|-----------|-------|----------|----------------|-------------|
| REDCOMB DRIVE | URBAN ACCESS ROAD | 5.9 x 10 ⁵ | 3 | 35mm | 150mm | 150mm | 200mm | 535mm |

~~NOTE: THIS PAVEMENT DESIGN IS PRELIMINARY ONLY BASED ON ASSUMED CBR. THE CONTRACTOR SHALL SUPPLY THE SUPERINTENDENT WITH SUBGRADE TEST RESULTS NECESSARY FOR FINAL PAVEMENT DESIGN. THE PAVEMENT DESIGN IS SUBJECT TO A SEPARATE PAVEMENT DESIGN APPROVAL BY COUNCIL.~~

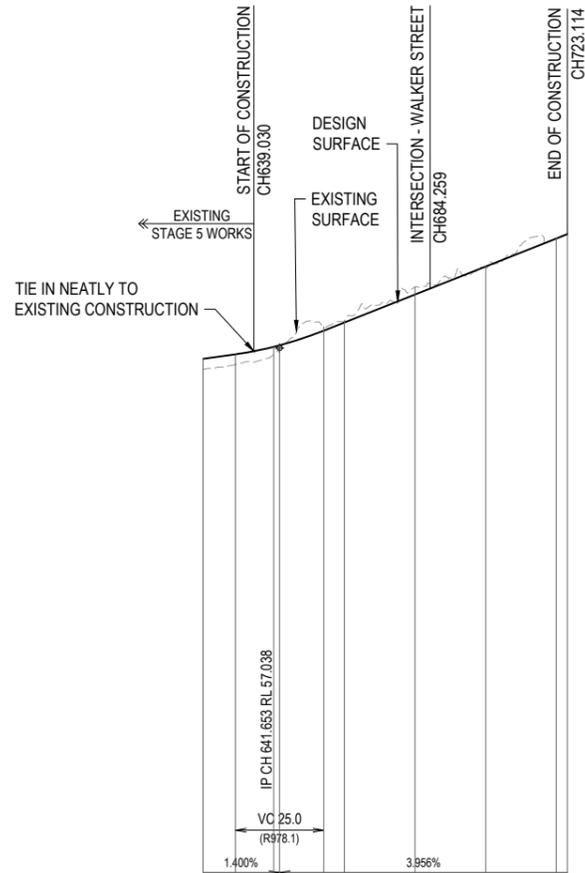


DATUM RL 41.0

| | 620.000 | 629.153 | 640.000 | 641.653 | 654.153 | 660.000 | 680.000 | 700.000 | 720.000 | 723.114 |
|-------------------|---------|---------|---------|---------|---------|---------|---------|---------|---------|---------|
| CUT (-) / FILL | 0.287 | 0.289 | 0.217 | 0.075 | -0.110 | -0.042 | -0.216 | 0.029 | -0.011 | -0.019 |
| LHS LIP LEVEL | 56.647 | 56.776 | 56.988 | 57.031 | 57.446 | 57.677 | # | | 60.050 | |
| RHS LIP LEVEL | 56.652 | 56.780 | 56.993 | 57.036 | 57.450 | 57.681 | 58.555 | 59.264 | 60.055 | 67.509 |
| DESIGN SURFACE | 56.735 | 56.863 | 57.075 | 57.118 | 57.532 | 57.764 | 58.655 | 59.346 | 60.137 | 60.261 |
| EXISTING SURFACE | 56.447 | 56.574 | 56.858 | 57.043 | 57.642 | 57.805 | 58.771 | 59.318 | 60.148 | 60.280 |
| CHAINAGES | 620.000 | 629.153 | 640.000 | 641.653 | 654.153 | 660.000 | 680.000 | 700.000 | 720.000 | 723.114 |
| HORIZONTAL CURVES | | | | | | | | | | |

REFER INTERSECTION DETAILS PLAN FOR KERB RETURN LONGITUDINAL SECTIONS
REDCOMB DRIVE

ENGINEER'S CERTIFICATION
I, Daniel Collins, hereby certify that:
As Constructed information shown on this plan is a true and correct record of the sizes, types, materials, classes etc., and it corresponds with the relevant approved Engineering Drawings.
[Signature]
RPEQ (signature) RPEQ No. 18631 Date: 17/03/25

| AS-CONSTRUCTED PAVEMENT DETAILS | | | | | | | | | |
|---------------------------------|-----------------------|---------------------------|------------|----------------------|------|-----------------------|--------------------------|-------------------------|--------------------|
| LOCATION | SECTION | ESA | DESIGN CBR | TOTAL PAVEMENT DEPTH | A C | BASE COURSE CLASS (1) | UPPER SUB-BASE CLASS (2) | BLANKET COURSE TYPE (3) | SUBGRADE TREATMENT |
| REDCOMB DRIVE | CH639.030 - CH723.114 | 5.9 x 10 ⁵ UAR | 10% | 335mm | 35mm | 150mm | 150mm | | |

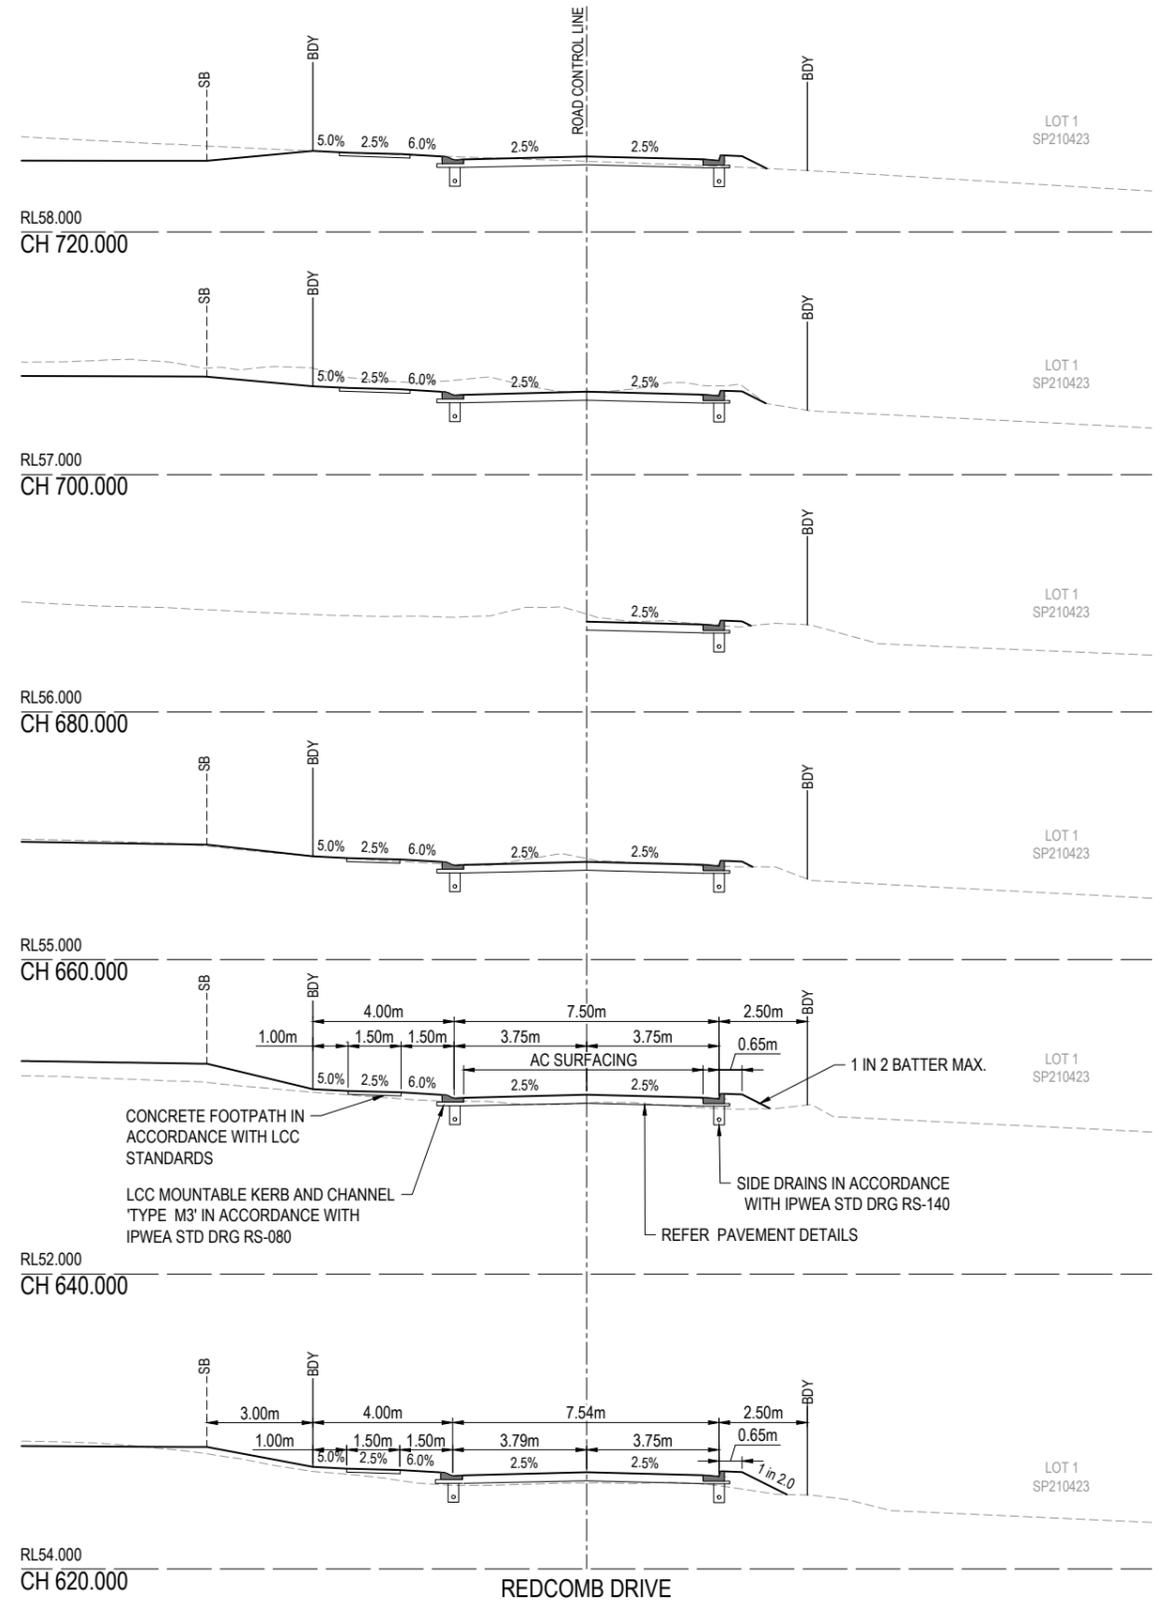

| REV | DATE | DESIGN | DRAWN | ISSUED FOR CONSTRUCTION | REVISION DETAILS |
|-----|----------|--------|-------|-------------------------|------------------|
| 0 | 26.08.24 | CL | AK | ISSUED FOR CONSTRUCTION | |
| 1 | 17.03.25 | CL | BP | AS CONSTRUCTED | |

| DRAWN | STATUS |
|-------|-----------------------|
| | AS CONSTRUCTED |



| SCALE | CROSS SECTIONS | HORIZONTAL | VERTICAL |
|--------|------------------------|------------------|------------------|
| 1:100 | 1 0 1 2 3 4 5 A1 | 1 0 1 2 3 4 5 A1 | 1 0 1 2 3 4 5 A1 |
| 1:200 | 1 0 1 2 3 4 5 A3 | 1 0 1 2 3 4 5 A1 | 1 0 1 2 3 4 5 A1 |
| 1:1000 | 10 0 10 20 30 40 50 A1 | 1 0 1 2 3 4 5 A1 | 1 0 1 2 3 4 5 A1 |
| 1:2000 | 1 0 1 2 3 4 5 A1 | 1 0 1 2 3 4 5 A1 | 1 0 1 2 3 4 5 A1 |

CLIENT
HB Land
ASSOCIATED CONSULTANT
SAUNDERS HAVILL GROUP
PH: 1300 123 744

PROJECT NAME
TILLERMAN PARK RIDGE
STAGE 7
133-159 PARK RIDGE ROAD, PARK RIDGE

| DRAWING TITLE | PROJECT No. | DRAWING No. | REVISION |
|--|-------------|-------------|----------|
| REDCOMB DRIVE LONGITUDINAL SECTION AND CROSS SECTIONS | 22-0448 | 107 | 1 |


ASSUMED PAVEMENT DETAILS (SUBJECT TO CBR TESTING)

| ROAD | ROAD CLASSIFICATION | DESIGN ESAS | ASSUMED CBR | SURFACING | BASE | SUB BASE | LOWER SUB BASE | TOTAL DEPTH |
|---------------|---------------------|-----------------------|-------------|-----------|-------|----------|----------------|-------------|
| WALKER STREET | URBAN ACCESS ROAD | 5.9 x 10 ⁵ | 3 | 35mm | 150mm | 150mm | 200mm | 535mm |

NOTE: THIS PAVEMENT DESIGN IS PRELIMINARY ONLY BASED ON ASSUMED CBR. THE CONTRACTOR SHALL SUPPLY THE SUPERINTENDENT WITH SUBGRADE TEST RESULTS NECESSARY FOR FINAL PAVEMENT DESIGN. THE PAVEMENT DESIGN IS SUBJECT TO A SEPARATE PAVEMENT DESIGN APPROVAL BY COUNCIL.

AS-CONSTRUCTED PAVEMENT DETAILS

| LOCATION | SECTION | ESA | DESIGN CBR | TOTAL PAVEMENT DEPTH | A C | BASE COURSE CLASS (1) | UPPER SUB-BASE CLASS (2) | BLANKET COURSE TYPE (3) | SUBGRADE TREATMENT |
|---------------|-----------------------|---------------------------|------------|----------------------|------|-----------------------|--------------------------|-------------------------|--------------------|
| WALKER STREET | CH105.845 - CH366.886 | 5.9 x 10 ⁵ UAR | 10% | 335mm | 35mm | 150mm | 150mm | | - |

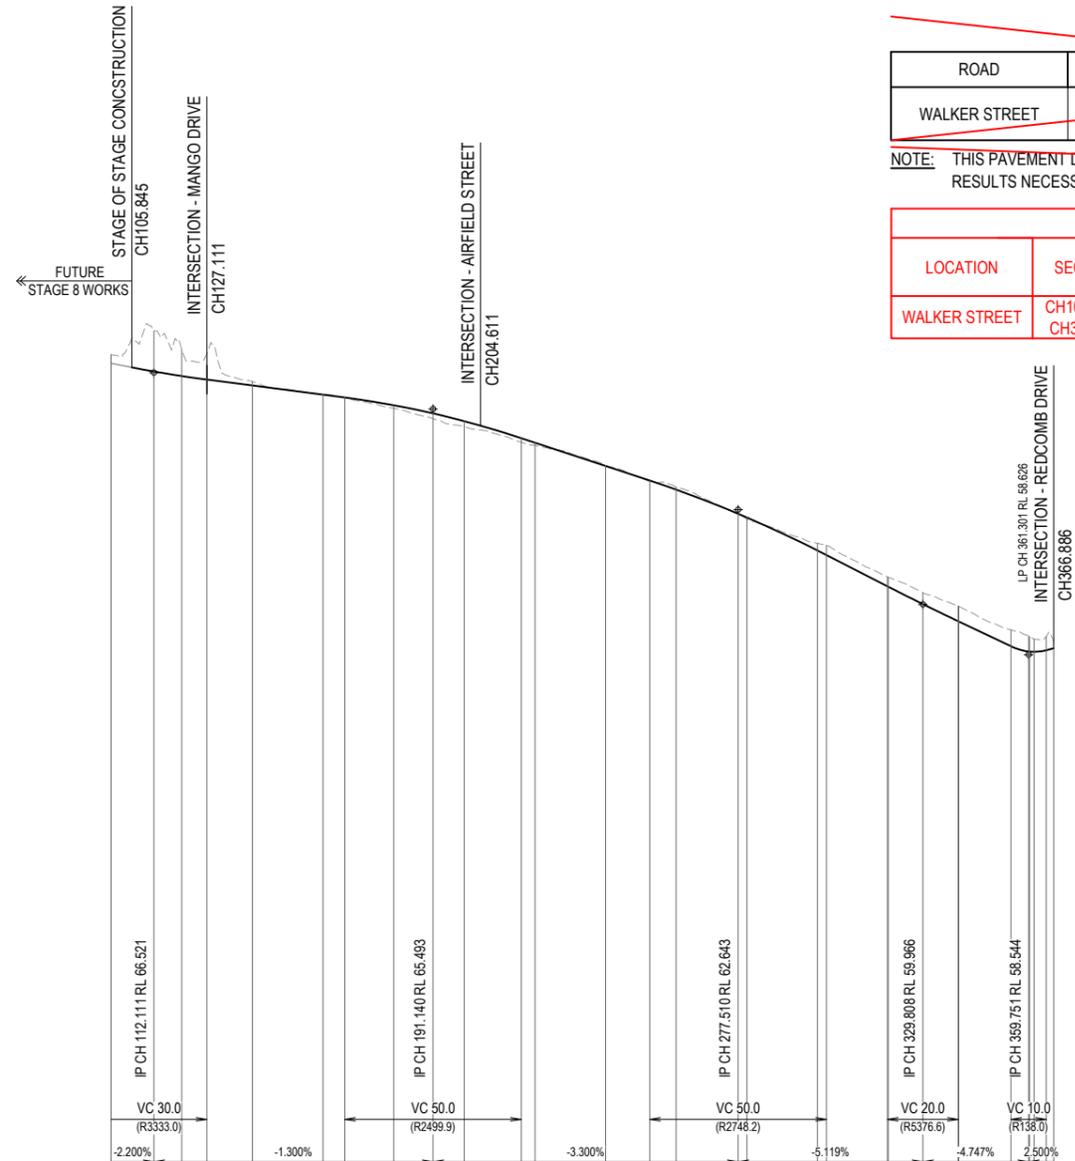

DATUM RL 43.0

| CHAINAGES | 100.000 | 112.111 | 120.000 | 127.111 | 140.000 | 160.000 | 166.140 | 180.000 | 191.140 | 200.000 | 216.140 | 220.000 | 240.000 | 252.510 | 260.000 | 277.510 | 280.000 | 300.000 | 302.510 | 319.808 | 320.000 | 329.808 | 339.808 | 340.000 | 354.751 | 360.000 | 361.301 | 364.751 | 366.886 | |
|-------------------|---------|---------|---------|---------|---------|---------|---------|---------|---------|---------|---------|---------|---------|---------|---------|---------|---------|---------|---------|---------|---------|---------|---------|---------|---------|---------|---------|---------|---------|--------|
| CUT (-) / FILL | | -0.242 | -1.146 | -0.750 | -0.723 | | | 0.083 | 0.147 | 0.155 | 0.114 | 0.079 | -0.012 | 0.017 | -0.072 | 0.008 | 0.041 | -0.205 | -0.276 | -0.260 | -0.262 | -0.321 | -0.430 | -0.431 | -0.463 | -0.434 | -0.422 | -0.361 | -0.383 | -0.173 |
| LHS LIP LEVEL | 66.701 | 66.467 | 66.339 | 66.239 | 66.071 | 65.811 | 65.731 | 65.513 | 65.281 | 65.062 | 64.581 | 64.454 | 63.794 | 63.381 | 63.124 | 62.442 | 62.337 | 61.404 | 61.276 | 60.391 | 60.381 | 59.888 | 59.404 | 59.395 | 58.782 | 58.635 | 58.632 | 58.626 | 58.669 | 58.723 |
| RHS LIP LEVEL | 66.701 | 66.467 | # | # | 66.071 | 65.811 | 65.731 | 65.513 | 65.281 | 65.062 | 64.581 | 64.454 | 63.794 | 63.381 | 63.124 | 62.442 | 62.337 | 61.404 | 61.276 | 60.391 | 60.381 | 59.888 | 59.404 | 59.395 | 58.782 | 58.635 | 58.632 | 58.626 | 58.669 | 58.723 |
| DESIGN SURFACE | 66.788 | 66.554 | 66.426 | 66.326 | 66.158 | 65.898 | 65.818 | 65.600 | 65.368 | 65.149 | 64.668 | 64.541 | 63.881 | 63.468 | 63.211 | 62.529 | 62.424 | 61.491 | 61.363 | 60.478 | 60.468 | 59.975 | 59.491 | 59.482 | 58.869 | 58.723 | 58.632 | 58.626 | 58.669 | 58.723 |
| EXISTING SURFACE | 67.030 | 67.701 | 67.176 | 67.049 | 66.269 | 65.906 | 65.813 | 65.517 | 65.222 | 64.994 | 64.554 | 64.462 | 63.893 | 63.451 | 63.282 | 62.521 | 62.382 | 61.696 | 61.639 | 60.738 | 60.730 | 60.296 | 59.821 | 59.813 | 59.245 | 59.069 | 59.054 | 58.987 | 59.053 | 58.896 |
| HORIZONTAL CURVES | | | | | | | | | | | | | | | | | | | | | | | | | | | | | | |

REFER INTERSECTION DETAILS PLAN FOR KERB RETURN LONGITUDINAL SECTIONS WALKER STREET

ENGINEER'S CERTIFICATION
 I, Daniel Collins, hereby certify that:
 As Constructed information shown on this plan is a true and correct record of the sizes, types, materials, classes etc., and it corresponds with the relevant approved Engineering Drawings.
 RPEQ (signature) RPEQ No. 18631 Date: 17/03/25



| | | | | | | | | | | | | | |
|---|----------|--------|-------|-------------------------|------------------|-----------------------|----------------|---|---|------------|------------------|---|--|
| REV | DATE | DESIGN | DRAWN | ISSUED FOR CONSTRUCTION | REVISION DETAILS | DRAWN | STATUS | | SCALE 1:1000 10 0 10 20 30 40 50 A1 1:2000 HORIZONTAL A3 1:100 2 1 0 2 4 A1 1:200 VERTICAL A3 | CLIENT | PROJECT NAME | DRAWING TITLE WALKER STREET LONGITUDINAL SECTION | |
| 0 | 26.08.24 | CL | AK | ISSUED FOR CONSTRUCTION | | | AS CONSTRUCTED | | | | | | |
| 1 | 17.03.25 | CL | BP | AS CONSTRUCTED | | | | | | | | | |
| DESIGN APPROVED | | | | | | DATE | | | | | | | |
| DANIEL COLLINS | | | | | | 17.03.25 | | | | | | | |
| FOR AND ON BEHALF OF COLLIER'S INTERNATIONAL ENGINEERING & DESIGN PTY LTD | | | | | | RPEQ 18631 | | | | | | | |
| | | | | | | ASSOCIATED CONSULTANT | | SAUNDERS HAVILL GROUP PH: 1300 123 744 | | | | | |
| | | | | | | PROJECT No. | | 22-0448 | | | | | |
| | | | | | | DRAWING No. | | 108 | | | | | |
| | | | | | | REVISION | | 1 | | | | | |

ENGINEER'S CERTIFICATION

I, Daniel Collins, hereby certify that:
As Constructed information shown on this plan is a true and correct record of the sizes, types, materials, classes etc., and it corresponds with the relevant approved Engineering Drawings.



RPEQ (signature) RPEQ No. 18631 Date: 17/03/25

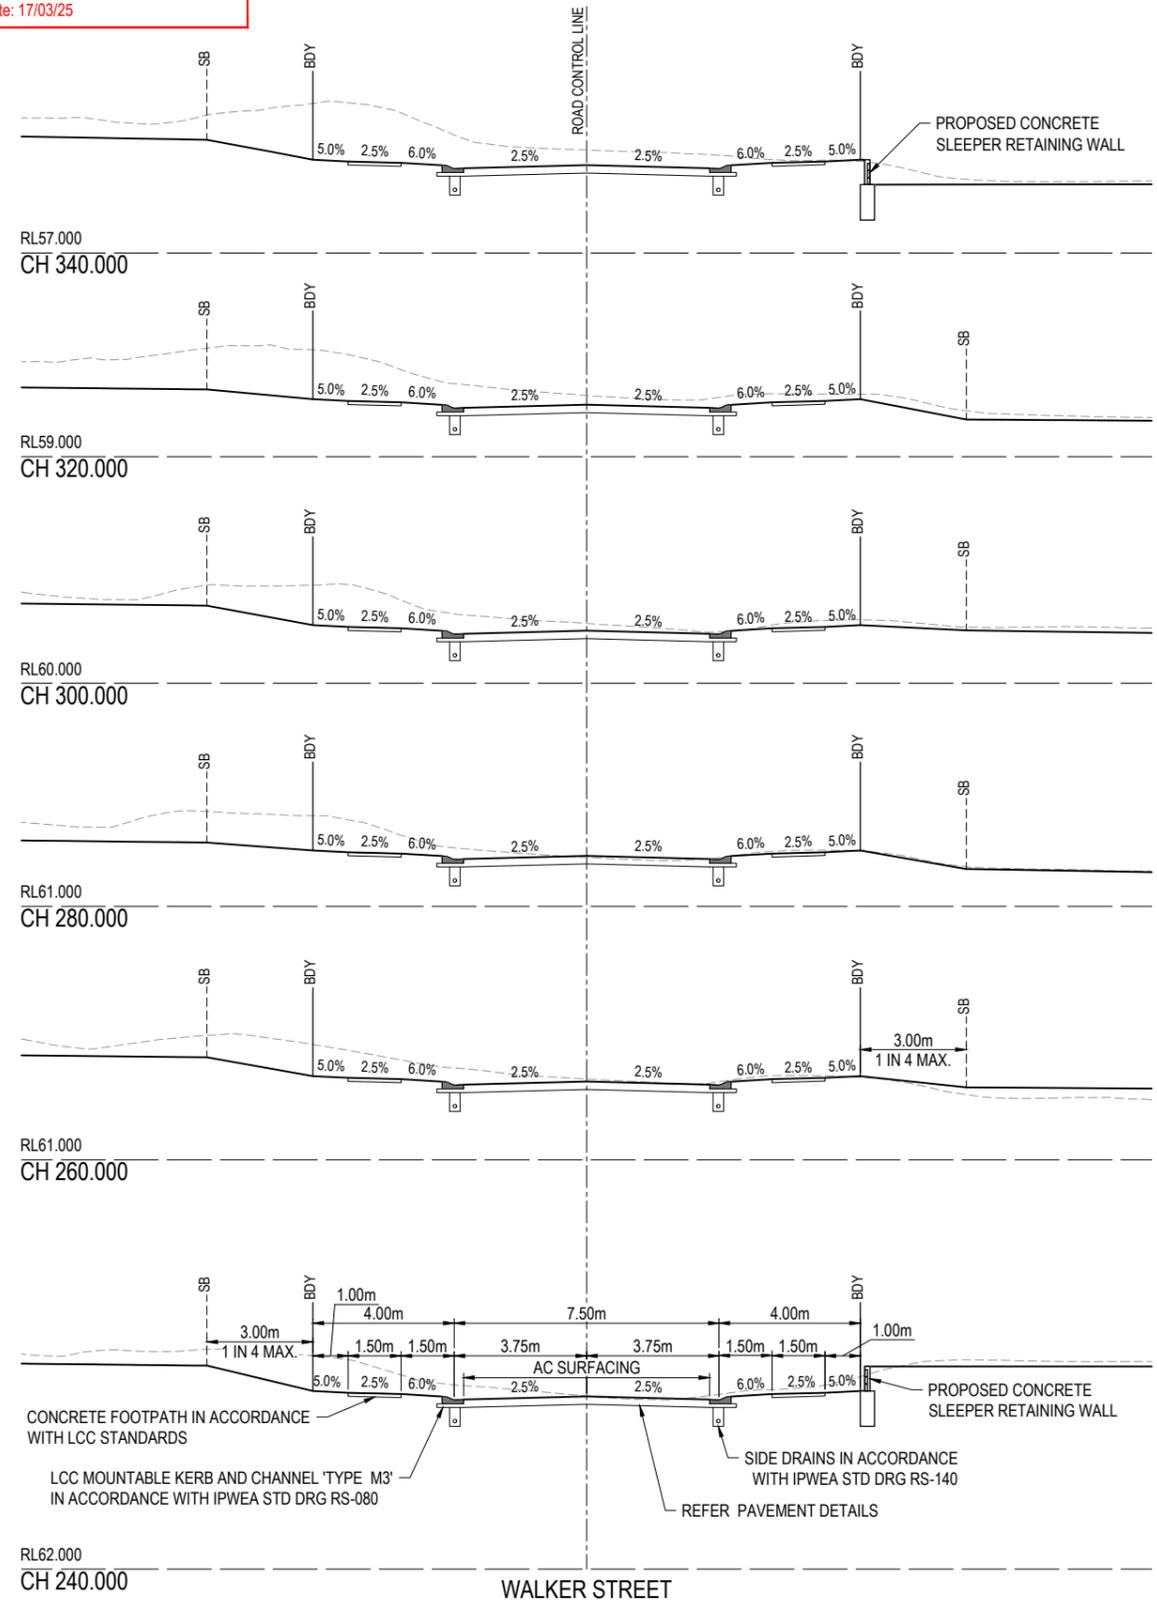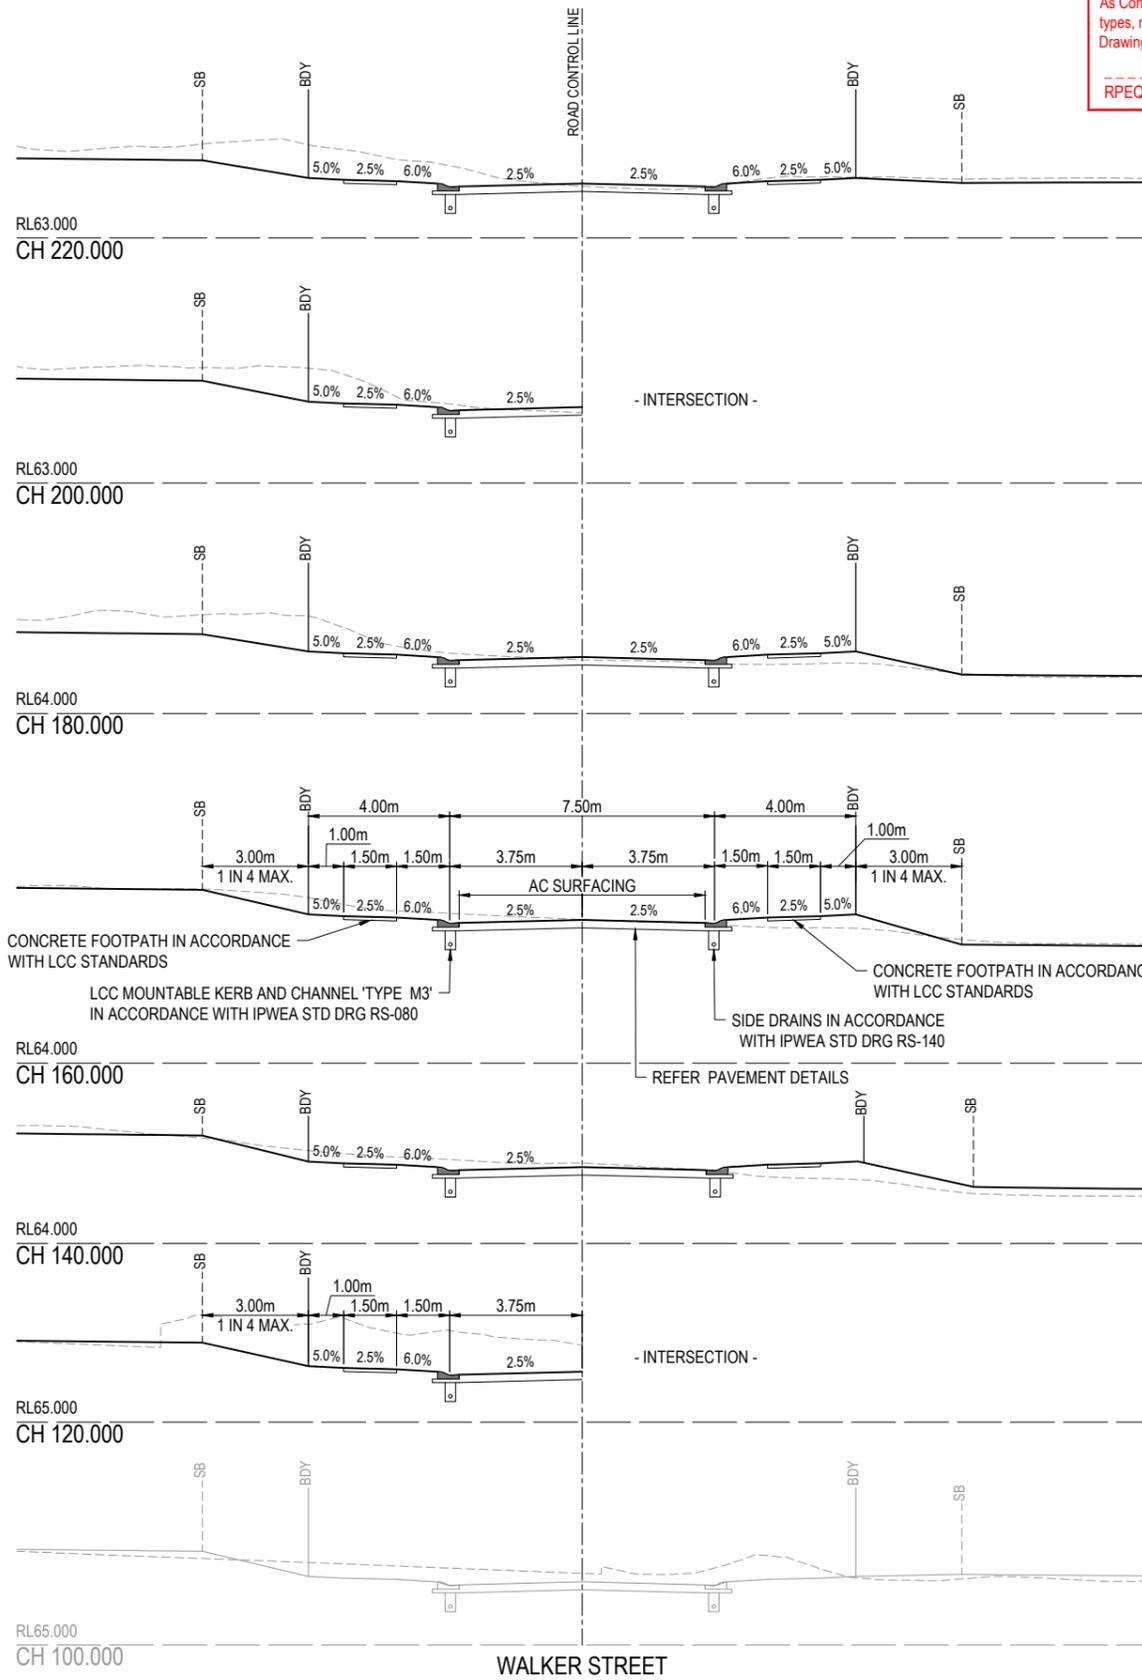

| REV | DATE | DESIGN | DRAWN | ISSUED FOR CONSTRUCTION |
|-----|----------|--------|-------|-------------------------|
| 0 | 26.08.24 | CL | AK | ISSUED FOR CONSTRUCTION |
| 1 | 17.03.25 | CL | BP | AS CONSTRUCTED |

| DRAWN | STATUS |
|-------|-----------------------|
| | AS CONSTRUCTED |



| DESIGN | APPROVED | DATE |
|--------|----------------|----------|
| | DANIEL COLLINS | 17.03.25 |

CLIENT



ASSOCIATED CONSULTANT
SAUNDERS HAVILL GROUP
PH: 1300 123 744

PROJECT NAME



STAGE 7
133-159 PARK RIDGE ROAD, PARK RIDGE

| DRAWING TITLE | PROJECT No. | DRAWING No. | REVISION |
|-------------------------------------|-------------|-------------|----------|
| WALKER STREET CROSS SECTIONS | 22-0448 | 109 | 1 |


ASSUMED PAVEMENT DETAILS (SUBJECT TO CBR TESTING)

| ROAD | ROAD CLASSIFICATION | DESIGN ESAs | ASSUMED CBR | SURFACING | BASE | SUB BASE | LOWER SUB BASE | TOTAL DEPTH |
|-------------|---------------------|-----------------------|-------------|-----------|-------|----------|----------------|-------------|
| MANGO DRIVE | URBAN ACCESS ROAD | 5.9 x 10 ⁵ | 3 | 35mm | 150mm | 150mm | 200mm | 535mm |

NOTE: THIS PAVEMENT DESIGN IS PRELIMINARY ONLY BASED ON ASSUMED CBR. THE CONTRACTOR SHALL SUPPLY THE SUPERINTENDENT WITH SUBGRADE TEST RESULTS NECESSARY FOR FINAL PAVEMENT DESIGN. THE PAVEMENT DESIGN IS SUBJECT TO A SEPARATE PAVEMENT DESIGN APPROVAL BY COUNCIL.

AS-CONSTRUCTED PAVEMENT DETAILS

| LOCATION | SECTION | ESA | DESIGN CBR | TOTAL PAVEMENT DEPTH | A C | BASE COURSE CLASS (1) | UPPER SUB-BASE CLASS (2) | BLANKET COURSE TYPE (3) | SUBGRADE TREATMENT |
|-------------|-------------------|---------------------------|------------|----------------------|------|-----------------------|--------------------------|-------------------------|--------------------|
| MANGO DRIVE | CH0.00 - CH33.433 | 5.9 x 10 ⁵ UAR | 9% | 335mm | 35mm | 150mm | 150mm | | - |

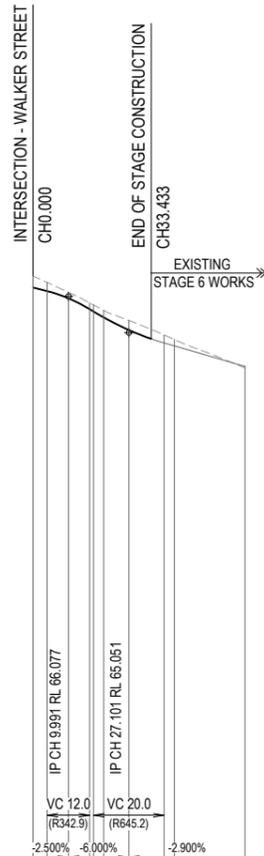

DATUM RL 49.0

| CUT (-) / FILL | 0.000 | 3.991 | 9.991 | 15.991 | 17.101 | 20.000 | 27.101 | 37.101 | 40.000 | 60.000 |
|-------------------|--------|--------|--------|--------|--------|--------|--------|--------|--------|--------|
| CUT (-) / FILL | -0.327 | -0.245 | -0.169 | -0.178 | -0.187 | -0.201 | -0.271 | -0.227 | -0.182 | 0.039 |
| LHS LIP LEVEL | | | | | | | | | | |
| RHS LIP LEVEL | | | | | | | | | | |
| DESIGN SURFACE | 66.327 | 66.227 | 66.025 | 65.717 | 65.630 | 65.564 | 65.396 | 64.674 | 64.590 | 64.010 |
| EXISTING SURFACE | 66.654 | 66.472 | 66.194 | 65.896 | 65.717 | 65.651 | 65.483 | 64.761 | 64.677 | 64.057 |
| CHAINAGES | 0.000 | 3.991 | 9.991 | 15.991 | 17.101 | 20.000 | 27.101 | 37.101 | 40.000 | 60.000 |
| HORIZONTAL CURVES | | | | | | | | | | |


REFER INTERSECTION DETAILS PLAN FOR KERB RETURN LONGITUDINAL SECTIONS

MANGO DRIVE

ENGINEER'S CERTIFICATION

I, Daniel Collins, hereby certify that:
As Constructed information shown on this plan is a true and correct record of the sizes, types, materials, classes etc., and it corresponds with the relevant approved Engineering Drawings.

RPEQ (signature) RPEQ No. 18631 Date: 17/03/25

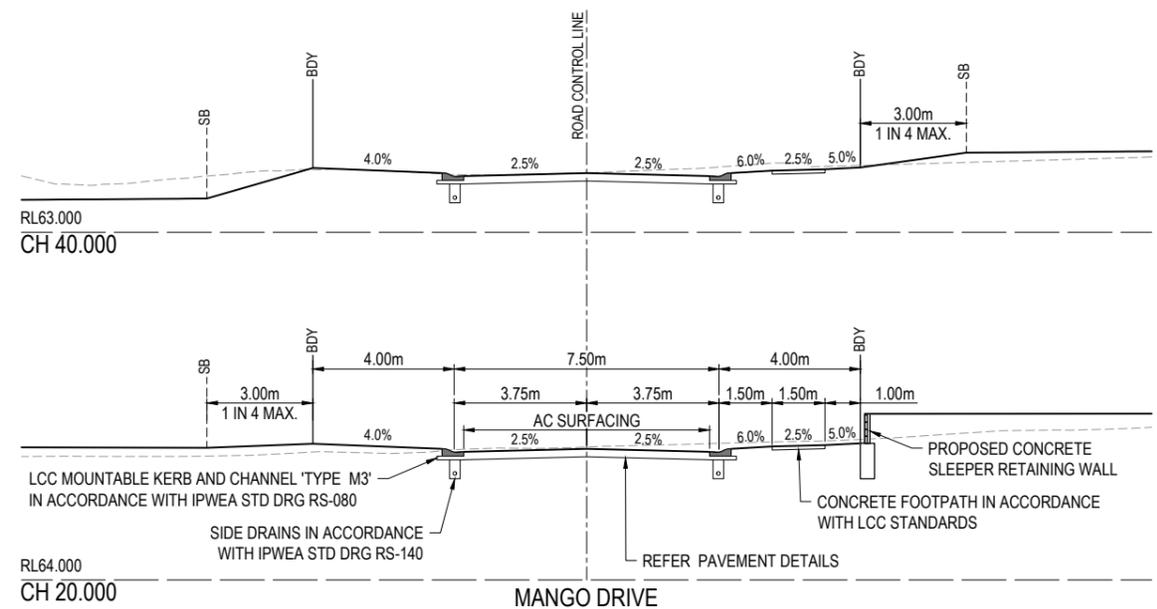

| REV | DATE | DESIGN | DRAWN | ISSUED FOR CONSTRUCTION | REVISION DETAILS | DRAWN | STATUS | SCALE | CLIENT | PROJECT NAME | DRAWING TITLE | |
|-----|----------|--------|-------|-------------------------|------------------|---|--|---|---|--|---|---------------|
| 0 | 26.08.24 | CL | AK | ISSUED FOR CONSTRUCTION | | | AS CONSTRUCTED | 1:100 CROSS SECTIONS 1:1000 HORIZONTAL 1:200 VERTICAL | HB Land | TILLERMAN PARK RIDGE | MANGO DRIVE LONGITUDINAL SECTION AND CROSS SECTIONS | |
| 1 | 17.03.25 | CL | BP | AS CONSTRUCTED | | | | | SAUNDERS HAVILL GROUP PH: 1300 123 744 | STAGE 7 133-159 PARK RIDGE ROAD, PARK RIDGE | | |
| | | | | | | DESIGN | APPROVED DANIEL COLLINS RPEQ 18631 DATE: 17.03.25 | | | PROJECT No. 22-0448 | DRAWING No. 110 | REVISION 1 |
| | | | | | | FOR AND ON BEHALF OF COLLIER'S INTERNATIONAL ENGINEERING & DESIGN PTY LTD | | | | | | |


ASSUMED PAVEMENT DETAILS (SUBJECT TO CBR TESTING)

| ROAD | ROAD CLASSIFICATION | DESIGN ESAS | ASSUMED CBR | SURFACING | BASE | SUB BASE | LOWER SUB BASE | TOTAL DEPTH |
|-----------------|---------------------|-----------------------|-------------|-----------|-------|----------|----------------|-------------|
| AIRFIELD STREET | URBAN ACCESS ROAD | 5.9 x 10 ⁵ | 3 | 35mm | 150mm | 150mm | 200mm | 535mm |

~~NOTE: THIS PAVEMENT DESIGN IS PRELIMINARY ONLY BASED ON ASSUMED CBR. THE CONTRACTOR SHALL SUPPLY THE SUPERINTENDENT WITH SUBGRADE TEST RESULTS NECESSARY FOR FINAL PAVEMENT DESIGN. THE PAVEMENT DESIGN IS SUBJECT TO A SEPARATE PAVEMENT DESIGN APPROVAL BY COUNCIL.~~

AS-CONSTRUCTED PAVEMENT DETAILS

| LOCATION | SECTION | ESA | DESIGN CBR | TOTAL PAVEMENT DEPTH | A C | BASE COURSE CLASS (1) | UPPER SUB-BASE CLASS (2) | BLANKET COURSE TYPE (3) | SUBGRADE TREATMENT |
|-----------------|-------------------|---------------------------|------------|----------------------|------|-----------------------|--------------------------|-------------------------|--------------------|
| AIRFIELD STREET | CH0.00 - CH33.620 | 5.9 x 10 ⁵ UAR | 7% | 385mm | 35mm | 150mm | 200mm | | - |

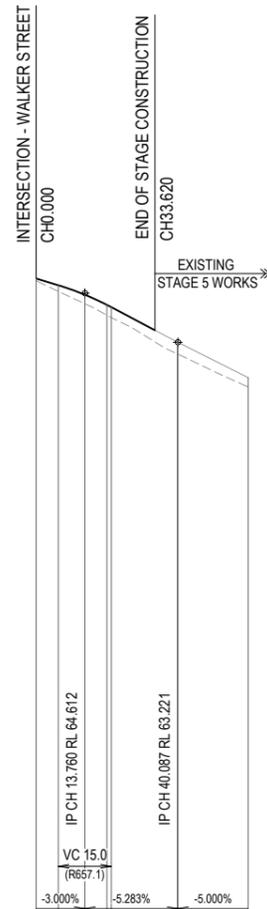

DATUM RL 46.0

| | 0.057 | 0.177 | 0.255 | 0.291 | 0.295 | 0.333 | 0.332 | 0.269 |
|-------------------|--------|--------|--------|--------|--------|--------|--------|--------|
| CUT (-) / FILL | | | | | | | | |
| LHS LIP LEVEL | | | | 64.194 | 64.129 | 63.139 | 63.134 | 62.139 |
| RHS LIP LEVEL | | | | 64.194 | 64.129 | 63.139 | 63.134 | 62.139 |
| DESIGN SURFACE | 65.025 | 64.837 | 64.569 | 64.281 | 64.216 | 63.226 | 63.221 | 62.226 |
| EXISTING SURFACE | 64.968 | 64.660 | 64.314 | 63.990 | 63.921 | 62.883 | 62.869 | 61.957 |
| CHAINAGES | 0.000 | 6.260 | 13.760 | 20.000 | 21.260 | 40.000 | 40.087 | 60.000 |
| HORIZONTAL CURVES | | | | | | | | |


REFER INTERSECTION DETAILS PLAN FOR KERB RETURN LONGITUDINAL SECTIONS

AIRFIELD STREET

ENGINEER'S CERTIFICATION

I, Daniel Collins, hereby certify that:
As Constructed information shown on this plan is a true and correct record of the sizes, types, materials, classes etc., and it corresponds with the relevant approved Engineering Drawings.

RPEQ (signature) RPEQ No. 18631 Date: 17/03/25

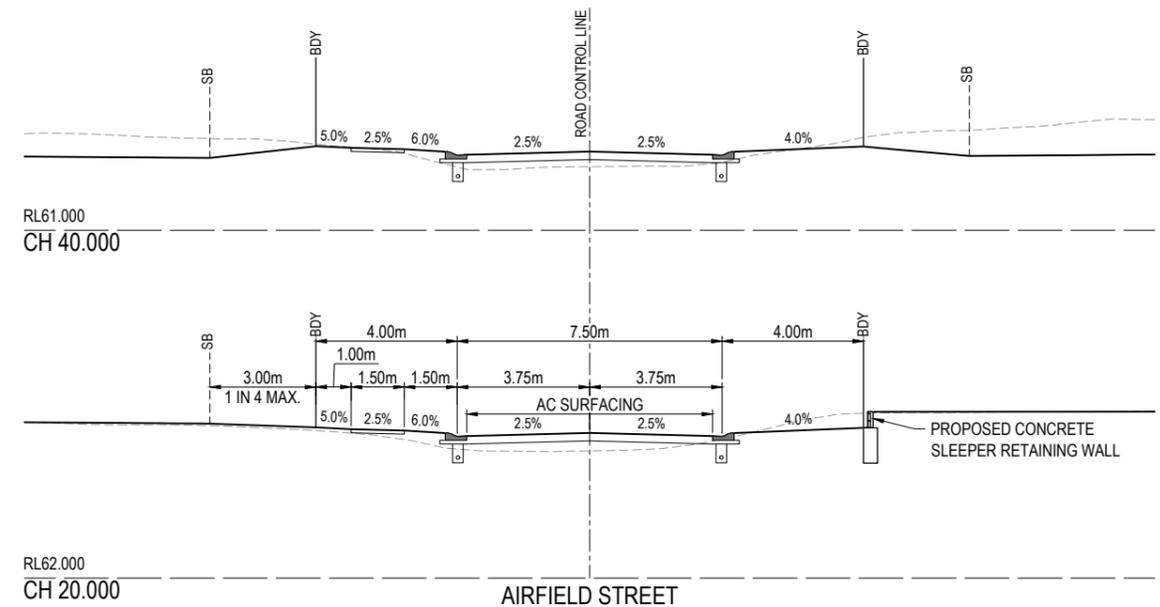

| REV | DATE | DESIGN | DRAWN | REVISION DETAILS |
|-----|----------|--------|-------|-------------------------|
| 0 | 26.08.24 | CL | AK | ISSUED FOR CONSTRUCTION |
| 1 | 17.03.25 | CL | BP | AS CONSTRUCTED |

| DRAWN | STATUS |
|-------|-----------------------|
| | AS CONSTRUCTED |



| SCALE | |
|--------|------------------------|
| 1:100 | 1 0 1 2 3 4 5 A1 |
| 1:200 | 1 0 1 2 3 4 5 A3 |
| 1:1000 | 10 0 10 20 30 40 50 A1 |
| 1:2000 | 10 0 10 20 30 40 50 A3 |
| 1:100 | 1 0 1 2 3 4 5 A1 |
| 1:200 | 1 0 1 2 3 4 5 A3 |

CLIENT
HB Land
ASSOCIATED CONSULTANT
SAUNDERS HAVILL GROUP
PH: 1300 123 744

PROJECT NAME
TILLERMAN PARK RIDGE
STAGE 7
133-159 PARK RIDGE ROAD, PARK RIDGE

| DRAWING TITLE | PROJECT No. | DRAWING No. | REVISION |
|--|-------------|-------------|----------|
| AIRFIELD STREET LONGITUDINAL SECTION AND CROSS SECTIONS | 22-0448 | 111 | 1 |

KERB TYPES NOTE:
REFER TO THE SURVEY SETOUT ENGINEERING DRAWING FOR KERB TYPES AND TRANSITION LOCATIONS

ENGINEER'S CERTIFICATION

I, Daniel Collins, hereby certify that:
As Constructed information shown on this plan is a true and correct record of the sizes, types, materials, classes etc., and it corresponds with the relevant approved Engineering Drawings.

RPEQ (signature) RPEQ No. 18631 Date: 17/03/25

DATUM RL 63.0

| LIP LEVEL | NORTHING | EASTING | CHAINAGES | HORIZONTAL CURVES |
|-----------|------------|------------|-----------|-------------------|
| 64.482 | 935386.760 | 505145.429 | 0.000 | R-10.270 |
| 64.523 | 935385.767 | 505145.309 | 1.000 | |
| 64.615 | 935383.771 | 505145.363 | 3.000 | |
| 64.697 | 935382.264 | 505145.666 | 4.538 | |
| 64.786 | 935380.890 | 505146.160 | 6.000 | |
| 64.927 | 935379.088 | 505147.185 | 8.076 | |
| 64.991 | 935378.361 | 505147.753 | 9.000 | |
| 65.140 | 935376.611 | 505149.687 | 11.615 | |
| 65.158 | 935376.397 | 505150.008 | 12.000 | |
| 65.262 | 935375.166 | 505152.732 | 15.000 | |
| 65.266 | 935375.125 | 505152.879 | 15.153 | |
| 65.288 | 935374.912 | 505153.856 | 16.153 | |

KR 26

RL 64.0

| | | | | |
|--------|------------|------------|--------|----------|
| 66.060 | 935366.646 | 505204.160 | 0.000 | R-10.270 |
| 66.073 | 935366.528 | 505204.160 | 1.000 | |
| 66.091 | 935366.596 | 505206.156 | 3.000 | |
| 66.093 | 935366.777 | 505207.217 | 4.078 | |
| 66.096 | 935367.389 | 505209.036 | 6.000 | |
| 66.060 | 935368.405 | 505210.819 | 8.056 | |
| 66.042 | 935368.987 | 505211.562 | 9.000 | |
| 65.968 | 935370.899 | 505213.289 | 11.583 | |
| 65.953 | 935371.246 | 505213.521 | 12.000 | |
| 65.818 | 935373.972 | 505214.746 | 15.000 | |
| 65.812 | 935374.079 | 505214.776 | 15.111 | |
| 65.759 | 935375.056 | 505214.991 | 16.111 | |

KR 27

RL 64.0

| | | | | |
|--------|------------|------------|--------|----------|
| 65.756 | 935373.946 | 505221.862 | 0.000 | R-10.270 |
| 65.809 | 935372.954 | 505221.743 | 1.000 | |
| 65.916 | 935370.957 | 505221.796 | 3.000 | |
| 65.998 | 935369.451 | 505222.100 | 4.538 | |
| 66.075 | 935368.076 | 505222.594 | 6.000 | |
| 66.184 | 935366.275 | 505223.619 | 8.076 | |
| 66.230 | 935365.547 | 505224.187 | 9.000 | |
| 66.337 | 935363.798 | 505226.121 | 11.615 | |
| 66.350 | 935363.564 | 505226.441 | 12.000 | |
| 66.426 | 935362.353 | 505229.165 | 15.000 | |
| 66.429 | 935362.312 | 505229.313 | 15.153 | |
| 66.446 | 935362.099 | 505230.289 | 16.153 | |

KR 28

RL 57.0

| | | | | |
|--------|------------|------------|--------|----------|
| 58.782 | 935394.847 | 504992.848 | 0.000 | R-10.270 |
| 58.639 | 935394.907 | 504995.859 | 3.000 | |
| 58.623 | 935394.859 | 504995.525 | 3.337 | |
| 58.574 | 935394.321 | 504987.508 | 5.428 | |
| 58.577 | 935394.104 | 504986.980 | 6.000 | |
| 58.563 | 935393.962 | 504986.674 | 6.337 | |
| 58.718 | 935392.905 | 504984.453 | 9.000 | |
| 58.747 | 935392.281 | 504984.201 | 9.337 | |
| 58.871 | 935391.270 | 504983.241 | 10.733 | |
| 58.973 | 935389.247 | 504982.495 | 12.000 | |
| 59.024 | 935389.616 | 504982.123 | 12.733 | |
| 59.128 | 935387.776 | 504981.345 | 14.733 | |
| 59.138 | 935387.520 | 504981.269 | 15.000 | |
| 59.189 | 935386.259 | 504980.996 | 16.291 | |

KR 23

RL 56.0

| | | | | |
|--------|------------|------------|--------|----------|
| 58.101 | 935413.451 | 504985.122 | 0.000 | R-10.270 |
| 58.141 | 935412.457 | 504985.021 | 1.000 | |
| 58.219 | 935410.462 | 504985.109 | 3.000 | |
| 58.278 | 935409.004 | 504985.426 | 4.493 | |
| 58.337 | 935407.595 | 504985.957 | 6.000 | |
| 58.413 | 935405.884 | 504986.960 | 7.986 | |
| 58.453 | 935405.094 | 504987.594 | 9.000 | |
| 58.556 | 935403.455 | 504989.447 | 11.480 | |
| 58.578 | 935403.171 | 504989.892 | 12.000 | |
| 58.714 | 935401.995 | 504992.601 | 14.973 | |
| 58.715 | 935401.988 | 504992.628 | 15.000 | |
| 58.761 | 935401.782 | 504993.578 | 15.973 | |

KR 24

RL 63.0

| | | | | |
|--------|------------|------------|--------|----------|
| 64.509 | 935379.459 | 505126.734 | 0.000 | R-10.270 |
| 64.542 | 935379.342 | 505127.727 | 1.000 | |
| 64.599 | 935379.399 | 505129.723 | 3.000 | |
| 64.631 | 935379.703 | 505131.219 | 4.528 | |
| 64.652 | 935380.202 | 505132.602 | 6.000 | |
| 64.665 | 935381.219 | 505134.385 | 8.056 | |
| 64.665 | 935381.393 | 505134.622 | 8.350 | |
| 64.664 | 935381.801 | 505135.128 | 9.000 | |
| 64.633 | 935383.713 | 505136.856 | 11.583 | |
| 64.624 | 935384.059 | 505137.087 | 12.000 | |
| 64.530 | 935386.786 | 505138.313 | 15.000 | |
| 64.525 | 935386.893 | 505138.342 | 15.111 | |
| 64.484 | 935387.869 | 505138.557 | 16.111 | |

KR 25

LEGEND

- PROPOSED ROAD CONTROL LINE
- PROPOSED KERB INVERT LINE
- PROPOSED CONCRETE PATH AND PRAM RAMP
- PROPOSED NEW ROAD PAVEMENT
- INDICATIVE DRIVEWAY LOCATION
- PROPOSED PAVEMENT CONTOUR (0.2m INTERVAL)
- PROPOSED KERB SETOUT LINE
- PROPOSED KERB SETOUT START POINT (SP)
- PROPOSED KERB SETOUT TANGENT POINT (TP)
- PROPOSED SLEEPER RETAINING WALL
- EXISTING DRAIN
- PROPOSED STORMWATER DRAINAGE PIPE
- EXISTING STORMWATER DRAINAGE PIPE
- PROPOSED SEWERAGE MAIN
- EXISTING SEWERAGE MAIN
- PROPOSED WATER MAIN
- EXISTING WATER MAIN
- PROPOSED WATER CONDUIT
- EXISTING ELECTRICAL CABLE U/G

ASCON LEGEND


- EDGE OF ROAD
- FOOTPATH

WARNING! - EXISTING SERVICES

EXTREME CARE SHOULD BE TAKEN WHEN EXCAVATING IN THIS AREA. THE FOLLOWING EXISTING SERVICES ARE LIKELY TO BE PRESENT IN THE VICINITY OF THE SITE:

- ELECTRICAL CABLES
- TELECOMMUNICATIONS CABLES
- GAS MAINS
- WATER MAINS
- SEWER MAINS

THE CONTRACTOR SHOULD CONTACT THE SERVICE PROVIDER FOR FURTHER INFORMATION AND SATISFY THEMSELVES OF ANY SPECIFIC TREATMENT OR REQUIREMENTS.

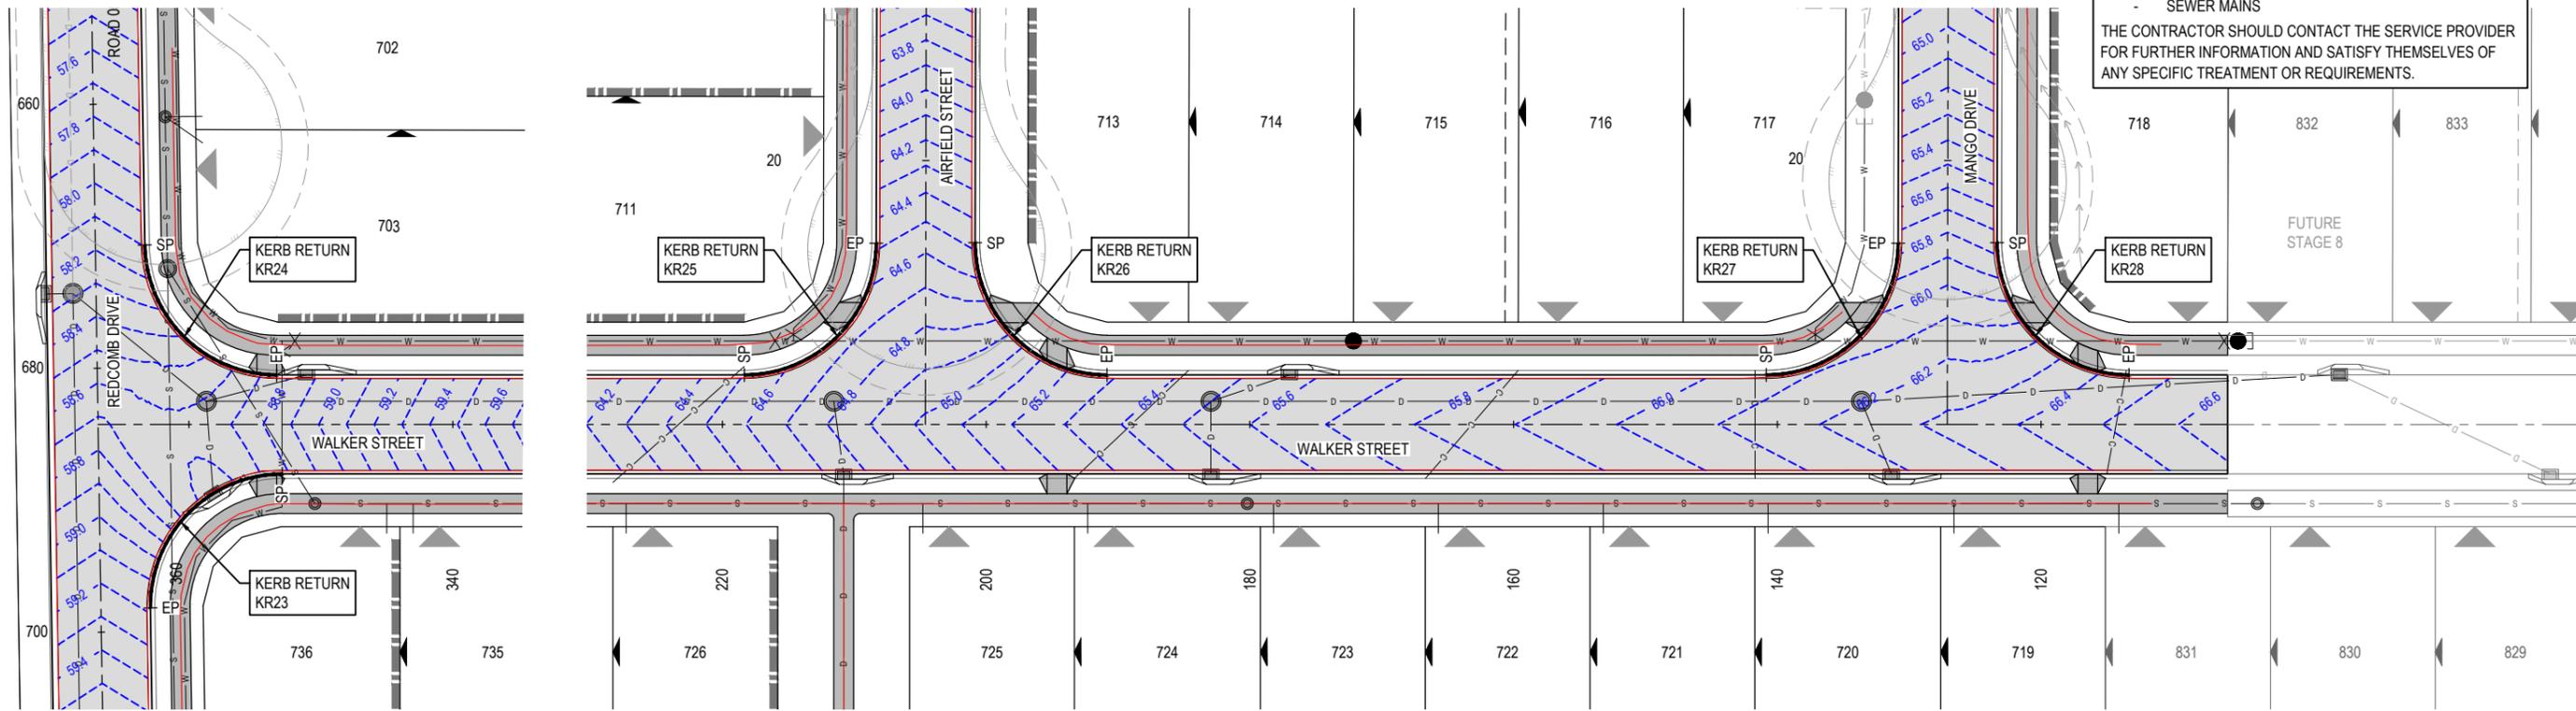

| <table border="1"> <thead> <tr> <th>REV</th> <th>DATE</th> <th>DESIGN</th> <th>DRAWN</th> <th>REVISION DETAILS</th> </tr> </thead> <tbody> <tr> <td>0</td> <td>26.08.24</td> <td>CL</td> <td>AK</td> <td>ISSUED FOR CONSTRUCTION</td> </tr> <tr> <td>1</td> <td>17.03.25</td> <td>CL</td> <td>BP</td> <td>AS CONSTRUCTED</td> </tr> </tbody> </table> | REV | DATE | DESIGN | DRAWN | REVISION DETAILS | 0 | 26.08.24 | CL | AK | ISSUED FOR CONSTRUCTION | 1 | 17.03.25 | CL | BP | AS CONSTRUCTED | <table border="1"> <thead> <tr> <th>DRAWN</th> <th>STATUS</th> </tr> </thead> <tbody> <tr> <td></td> <td>AS CONSTRUCTED</td> </tr> </tbody> </table> | DRAWN | STATUS | | AS CONSTRUCTED | | <p>SCALE</p> <p>1:250 0 5 10 A1</p> <p>1:500 0 5 10 A3</p> <p>LAYOUT</p> <p>1:250 0 5 10 A1</p> <p>1:500 0 5 10 A3</p> <p>HORIZONTAL</p> <p>1:25 0 0.25 0.5 0.75 1 1.25 A1</p> <p>1:50 0 0.25 0.5 0.75 1 1.25 A3</p> <p>VERTICAL</p> | <p>CLIENT</p> | <p>PROJECT NAME</p> <p>STAGE 7</p> <p>133-159 PARK RIDGE ROAD, PARK RIDGE</p> | <p>DRAWING TITLE</p> <p>INTERSECTION DETAILS LAYOUT PLAN</p> |
|---|-----------------------|----------|----------|-------------------------|------------------|----------------|----------|-------------------|----|---|---|----------------------------|------------------------|-------------------|----------------|---|-------|--------|--|-----------------------|--|--|---------------|---|---|
| REV | DATE | DESIGN | DRAWN | REVISION DETAILS | | | | | | | | | | | | | | | | | | | | | |
| 0 | 26.08.24 | CL | AK | ISSUED FOR CONSTRUCTION | | | | | | | | | | | | | | | | | | | | | |
| 1 | 17.03.25 | CL | BP | AS CONSTRUCTED | | | | | | | | | | | | | | | | | | | | | |
| DRAWN | STATUS | | | | | | | | | | | | | | | | | | | | | | | | |
| | AS CONSTRUCTED | | | | | | | | | | | | | | | | | | | | | | | | |
| <table border="1"> <thead> <tr> <th>DESIGN</th> <th>APPROVED</th> <th>DATE</th> </tr> </thead> <tbody> <tr> <td></td> <td>DANIEL COLLINS</td> <td>17.03.25</td> </tr> </tbody> </table> | | DESIGN | APPROVED | DATE | | DANIEL COLLINS | 17.03.25 | <p>RPEQ 18631</p> | | <p>ASSOCIATED CONSULTANT SAUNDERS HAVILL GROUP PH: 1300 123 744</p> | | <p>PROJECT No. 22-0448</p> | <p>DRAWING No. 112</p> | <p>REVISION 1</p> | | | | | | | | | | | |
| DESIGN | APPROVED | DATE | | | | | | | | | | | | | | | | | | | | | | | |
| | DANIEL COLLINS | 17.03.25 | | | | | | | | | | | | | | | | | | | | | | | |

LEGEND

-  PROPOSED AREA OF WORKS
-  PROPOSED STREET NAME SIGN
-  PROPOSED ROAD SIGN
-  PROPOSED END OF ROAD SIGN
-  EXISTING STREET NAME SIGN
-  EXISTING ROAD SIGN
-  EXISTING END OF ROAD SIGN
-  PROPOSED GIVE WAY LINE
-  PROPOSED LANE LINE - CONTINUOUS
-  EXISTING LINEMARKING (LINETYPES AS PER PROPOSED)



NOTES:

1. ALL SIGNS AND LINEMARKING SHALL BE IN ACCORDANCE WITH THE MANUAL OF UNIFORM TRAFFIC CONTROL DEVICES AND (L.C.C) STANDARDS.
2. TRAFFIC SIGN POSTS SHALL BE IN ACCORDANCE WITH (IPWEA RS-131) STANDARD DRAWINGS.
3. STREET NAME SIGN SHALL BE IN ACCORDANCE WITH (IPWEA RS-130) STANDARD DRAWINGS.
4. CONTRACTOR TO ENSURE SIGN LOCATIONS ARE CLEAR OF FUTURE DRIVEWAY LOCATIONS - LOCATE ON PB OR MID BLOCK. RRPMS TO BE INSTALLED / REMOVED AND REINSTATED TO SUIT NEW CHEVRON, MEDIAN AND EDGE LINE IN ACCORDANCE WITH M.U.T.C.D. REQUIREMENTS


ENGINEER'S CERTIFICATION

I, Daniel Collins, hereby certify that:
As Constructed information shown on this plan is a true and correct record of the sizes, types, materials, classes etc., and it corresponds with the relevant approved Engineering Drawings.

RPEQ (signature) RPEQ No. 18631 Date: 17/03/25


ASCON LEGEND

-  EDGE OF ROAD
-  FOOTPATH

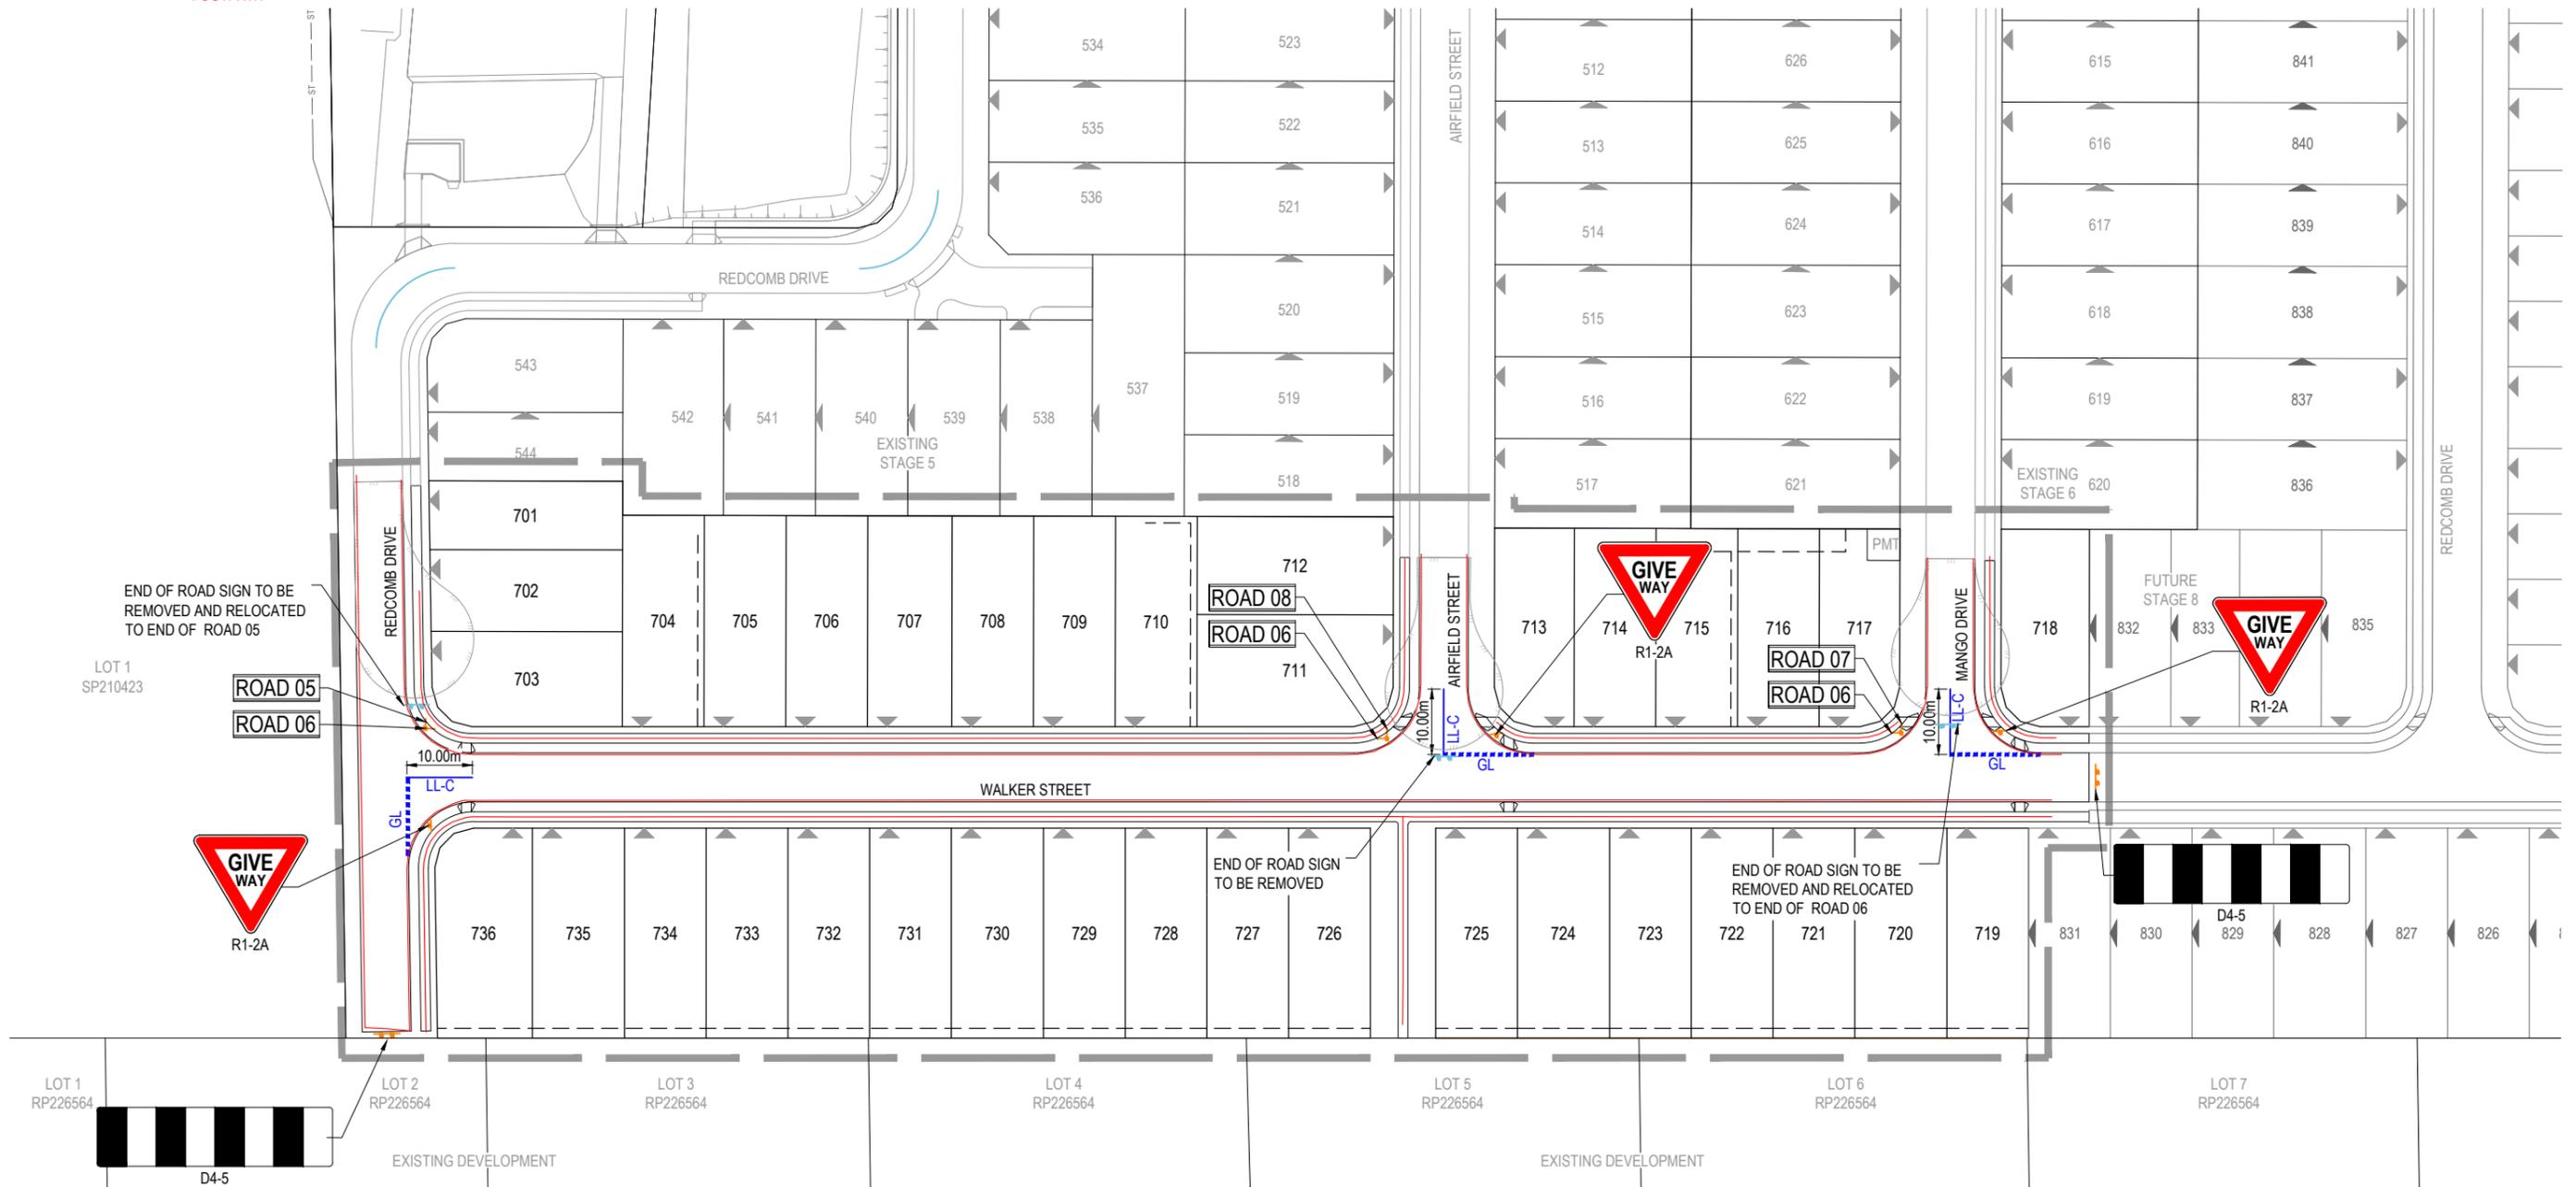

| REV | DATE | DESIGN | DRAWN | REVISION DETAILS |
|-----|----------|--------|-------|-------------------------|
| 0 | 26.08.24 | CL | AK | ISSUED FOR CONSTRUCTION |
| 1 | 17.03.25 | CL | BP | AS CONSTRUCTED |

| DRAWN | STATUS |
|-------|----------------|
| AK | AS CONSTRUCTED |
| BP | APPROVED |

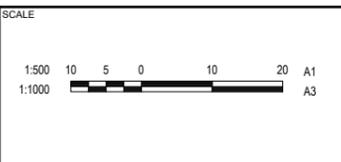


CLIENT

ASSOCIATED CONSULTANT
SAUNDERS HAVILL GROUP
PH: 1300 123 744

PROJECT NAME

STAGE 7
133-159 PARK RIDGE ROAD, PARK RIDGE

| DRAWING TITLE | | |
|-----------------------------------|-------------|----------|
| SIGNS AND LINEMARKING LAYOUT PLAN | | |
| PROJECT No. | DRAWING No. | REVISION |
| 22-0448 | 113 | 1 |

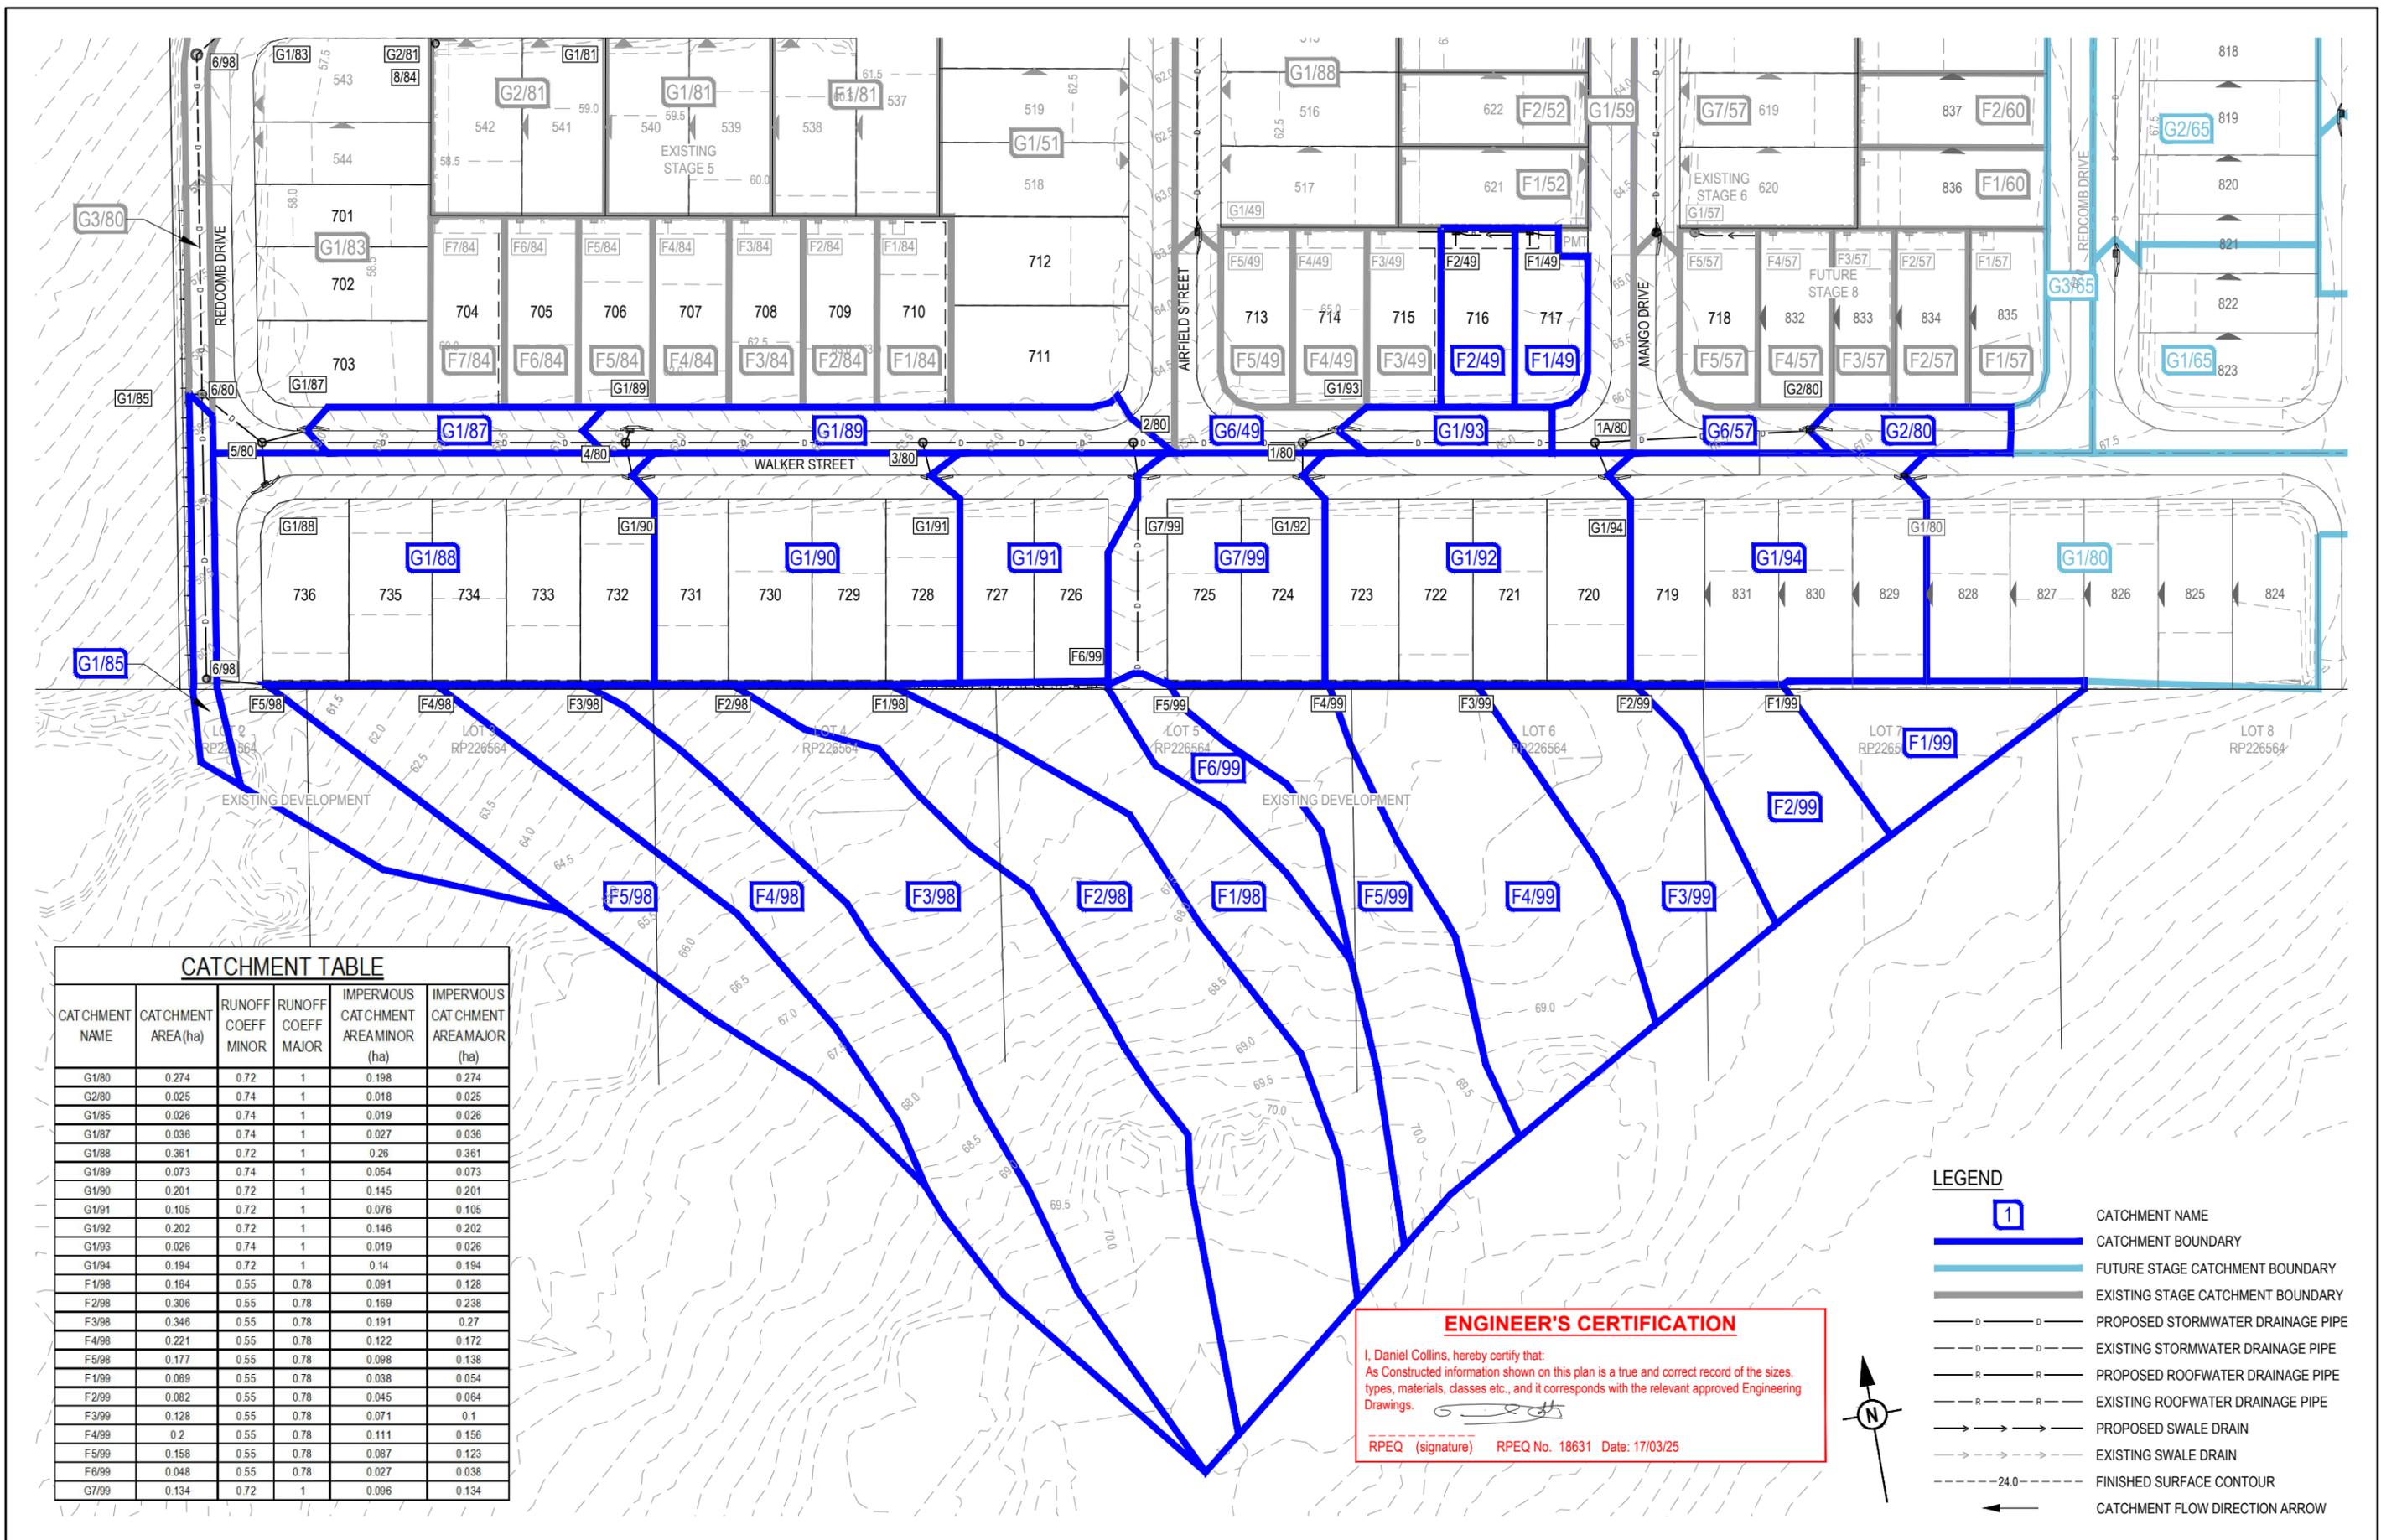

CATCHMENT TABLE

| CATCHMENT NAME | CATCHMENT AREA (ha) | RUNOFF COEFF MINOR | RUNOFF COEFF MAJOR | IMPERVIOUS CATCHMENT AREA MINOR (ha) | IMPERVIOUS CATCHMENT AREA MAJOR (ha) |
|----------------|---------------------|--------------------|--------------------|--------------------------------------|--------------------------------------|
| G1/80 | 0.274 | 0.72 | 1 | 0.198 | 0.274 |
| G2/80 | 0.025 | 0.74 | 1 | 0.018 | 0.025 |
| G1/85 | 0.026 | 0.74 | 1 | 0.019 | 0.026 |
| G1/87 | 0.036 | 0.74 | 1 | 0.027 | 0.036 |
| G1/88 | 0.361 | 0.72 | 1 | 0.26 | 0.361 |
| G1/89 | 0.073 | 0.74 | 1 | 0.054 | 0.073 |
| G1/90 | 0.201 | 0.72 | 1 | 0.145 | 0.201 |
| G1/91 | 0.105 | 0.72 | 1 | 0.076 | 0.105 |
| G1/92 | 0.202 | 0.72 | 1 | 0.146 | 0.202 |
| G1/93 | 0.026 | 0.74 | 1 | 0.019 | 0.026 |
| G1/94 | 0.194 | 0.72 | 1 | 0.14 | 0.194 |
| F1/98 | 0.164 | 0.55 | 0.78 | 0.091 | 0.128 |
| F2/98 | 0.306 | 0.55 | 0.78 | 0.169 | 0.238 |
| F3/98 | 0.346 | 0.55 | 0.78 | 0.191 | 0.27 |
| F4/98 | 0.221 | 0.55 | 0.78 | 0.122 | 0.172 |
| F5/98 | 0.177 | 0.55 | 0.78 | 0.098 | 0.138 |
| F1/99 | 0.069 | 0.55 | 0.78 | 0.038 | 0.054 |
| F2/99 | 0.082 | 0.55 | 0.78 | 0.045 | 0.064 |
| F3/99 | 0.128 | 0.55 | 0.78 | 0.071 | 0.1 |
| F4/99 | 0.2 | 0.55 | 0.78 | 0.111 | 0.156 |
| F5/99 | 0.158 | 0.55 | 0.78 | 0.087 | 0.123 |
| F6/99 | 0.048 | 0.55 | 0.78 | 0.027 | 0.038 |
| G7/99 | 0.134 | 0.72 | 1 | 0.096 | 0.134 |

ENGINEER'S CERTIFICATION
 I, Daniel Collins, hereby certify that:
 As Constructed information shown on this plan is a true and correct record of the sizes, types, materials, classes etc., and it corresponds with the relevant approved Engineering Drawings.
 RPEQ (signature) RPEQ No. 18631 Date: 17/03/25

- LEGEND**
- 1 CATCHMENT NAME
 - CATCHMENT BOUNDARY
 - FUTURE STAGE CATCHMENT BOUNDARY
 - EXISTING STAGE CATCHMENT BOUNDARY
 - PROPOSED STORMWATER DRAINAGE PIPE
 - EXISTING STORMWATER DRAINAGE PIPE
 - PROPOSED ROOFWATER DRAINAGE PIPE
 - EXISTING ROOFWATER DRAINAGE PIPE
 - PROPOSED SWALE DRAIN
 - EXISTING SWALE DRAIN
 - FINISHED SURFACE CONTOUR
 - CATCHMENT FLOW DIRECTION ARROW


| | |
|-----------------------|---|
| STRUCTURE NAME | G1/80 |
| STRUCTURE DESCRIPTION | STD TYPE A GULLY L.I.L.: 2.4m Limeit; TYPE M K&C |

STORMWATER STRUCTURE NOTE:
 STANDARD ROUND MANHOLES LESS THAN 3.0m DEEP:
 CONSTRUCT IN ACCORDANCE WITH THE LOCAL AUTHORITY STANDARDS.
 STANDARD ROUND MANHOLES 3.0m > 5.3m DEEP:
 CONSTRUCT IN ACCORDANCE WITH TMR STD DRAWINGS 1307 AND 1308.
 STANDARD ROUND MANHOLES GREATER THAN 5.3m DEEP:
 SHALL BE STRUCTURALLY DESIGNED (CERTIFIED) AND CONSTRUCTED BY CONTRACTOR ON A CASE BY CASE BASIS.
 ROUND EXTENDED (900mm MAX) MANHOLES:
 CONSTRUCT IN ACCORDANCE WITH COLLIER'S STD DRAWINGS S-101 & S-102.
 NON-STANDARD STRUCTURE (SPECIAL):
 SHALL BE STRUCTURALLY DESIGNED (CERTIFIED) AND CONSTRUCTED BY CONTRACTOR ON A CASE BY CASE BASIS.

HGL EVENT
 Q100
 Q2


| | | | | | | | | | | | | |
|--------------------------|-------|-------|-------|-------|-------|-------|-------|-------|--------|--------|-------|-------|
| PIPE SIZE (mm) | 375 | 375 | 375 | 375 | 375 | 375 | 375 | 375 | 525 | 600 | 750 | 1050 |
| PIPE CLASS | 3 | 3 | 3 | 3 | 3 | 3 | 3 | 3 | 3 | 3 | 3 | 3 |
| PIPE GRADE (%) | 1.15% | 1.08% | 1.27% | 2.21% | 3.06% | 4.15% | 5.35% | 2.42% | 1.83% | 2.42% | 0.50% | 0.30% |
| PIPE SLOPE (1 in X) | 86.64 | 92.56 | 78.60 | 45.21 | 32.65 | 24.40 | 18.70 | 41.33 | 200.00 | 333.33 | | |
| FULL PIPE VELOCITY (m/s) | 0.53 | 0.58 | 1.07 | 1.53 | 2.49 | 2.69 | 3.21 | 1.99 | 2.02 | 1.27 | 0.84 | |
| PART FULL VELOCITY (m/s) | 1.50 | 1.51 | 1.89 | 2.54 | 3.19 | 3.59 | 4.18 | 3.53 | 3.53 | 1.94 | 1.72 | |

| | |
|------------------------------------|-------------------------------------|
| DATUM RL | 48.0 |
| H.G.L IN PIPE & W.S.E IN STRUCTURE | 65.828 65.691 |
| PIPE FLOW (Cumecs) | 0.058 0.064 |
| PIPE CAPACITY AT GRADE (Cumecs) | 0.188 0.183 |
| DEPTH TO INVERT | 1.563 1.429 1.449 1.45 |
| INVERT LEVEL OF DRAIN | 65.516 65.312 65.202 65.25 |
| DESIGN SURFACE LEVEL | 67.079 66.744 66.74 |
| SETOUT COORDINATES | E 505260.629 N 935349.672 |
| RUNNING CHAINAGE | 0.000 17.674 |

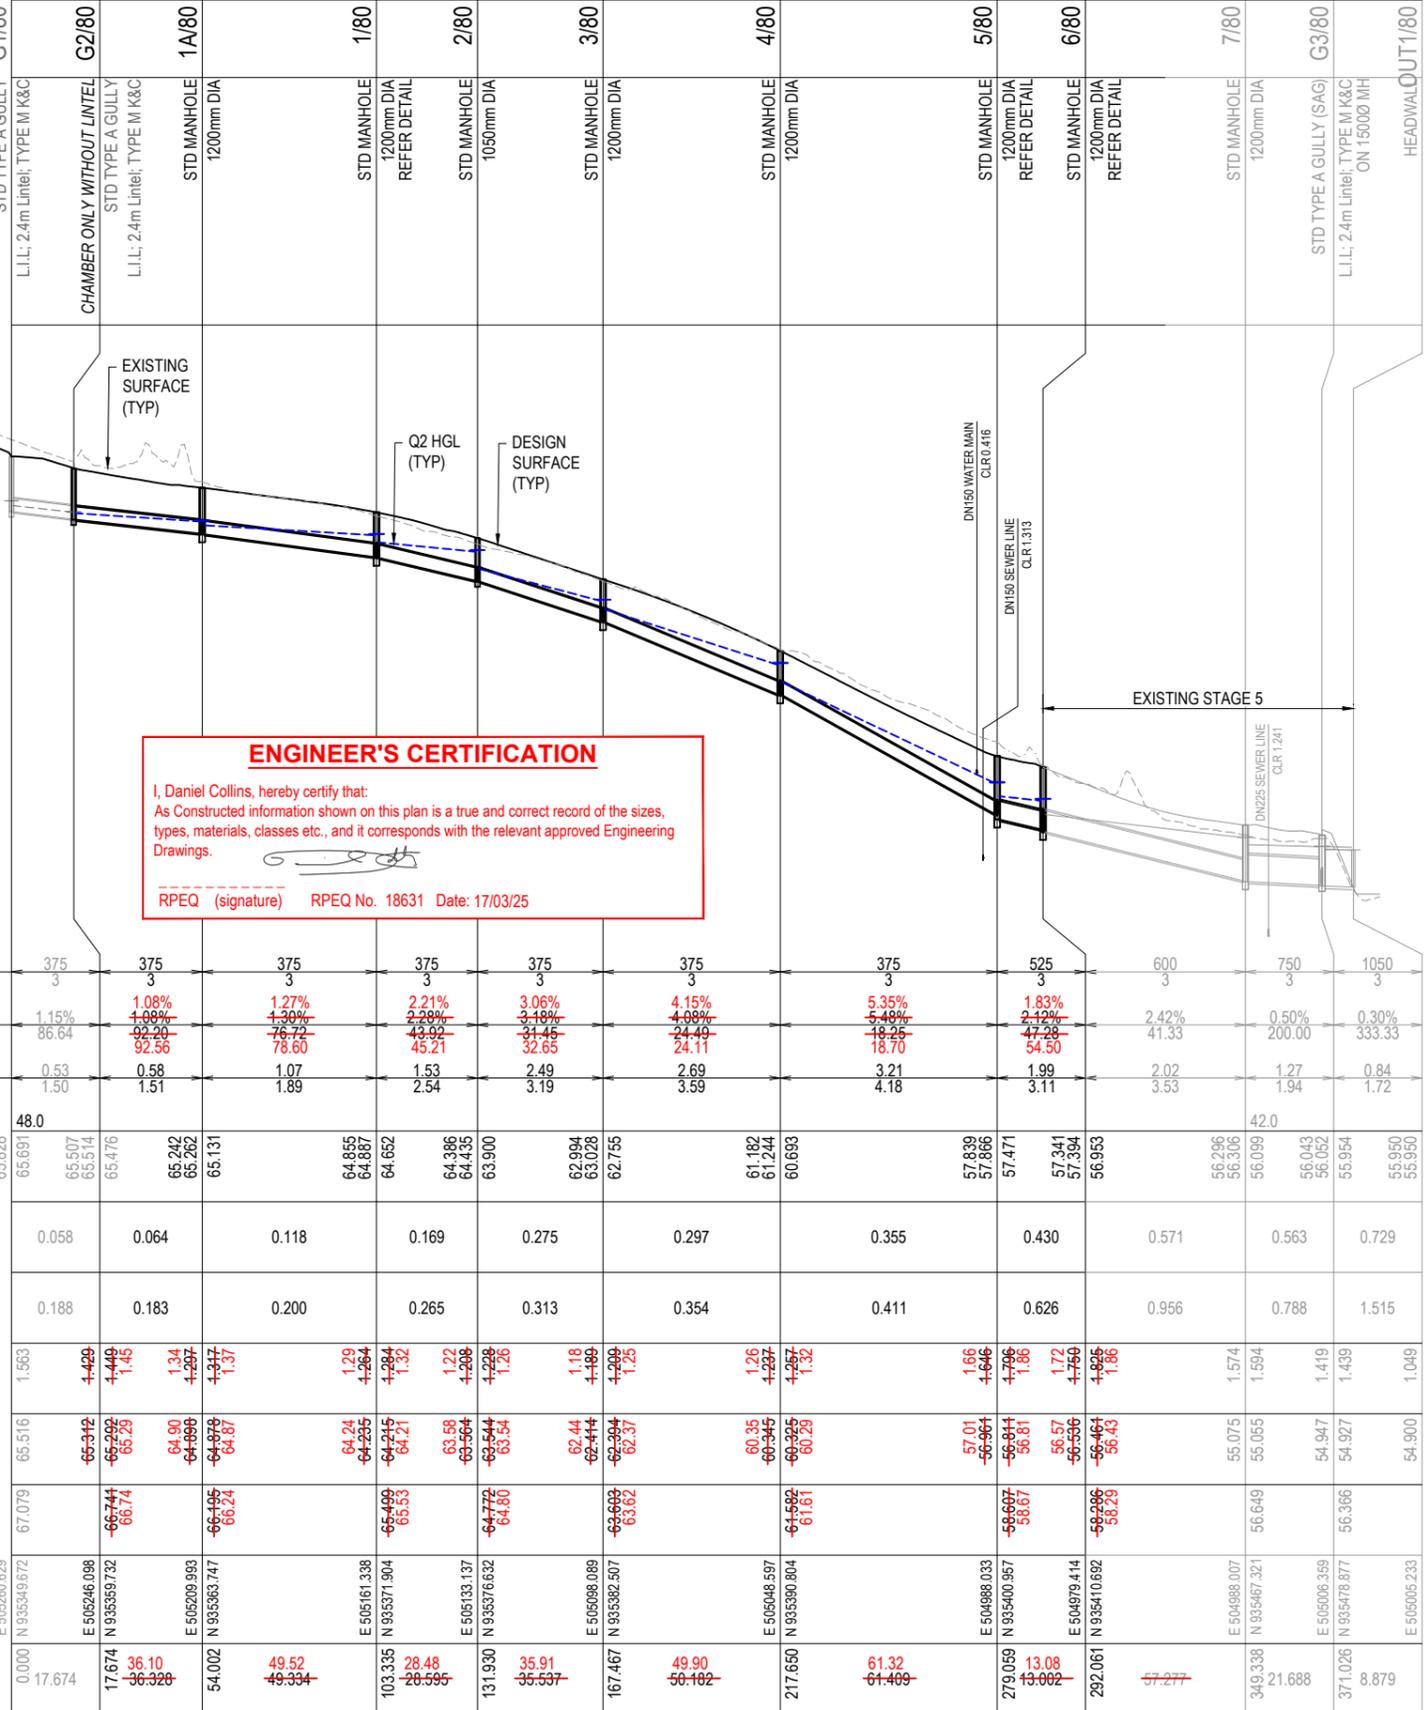


ENGINEER'S CERTIFICATION
 I, Daniel Collins, hereby certify that:
 As Constructed information shown on this plan is a true and correct record of the sizes, types, materials, classes etc., and it corresponds with the relevant approved Engineering Drawings.
 RPEQ (signature) RPEQ No. 18631 Date: 17/03/25

LINE

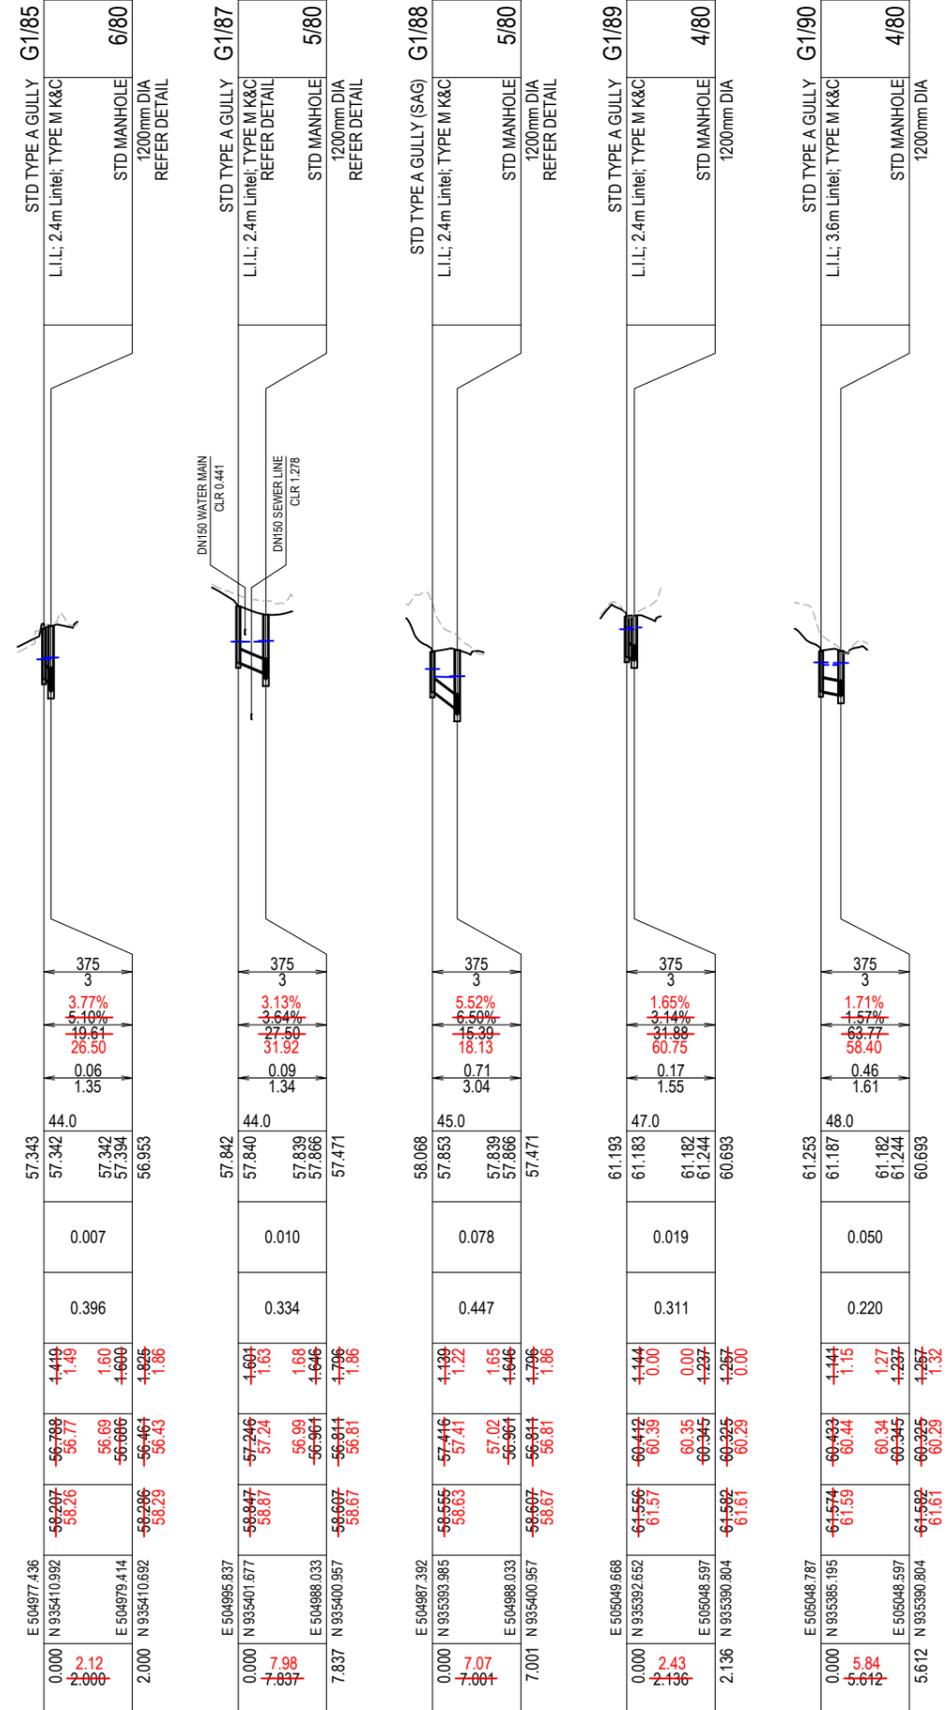

| REV | DATE | DESIGN | DRAWN | REVISION DETAILS |
|-----|----------|--------|-------|-------------------------|
| 0 | 26.08.24 | CL | AK | ISSUED FOR CONSTRUCTION |
| 1 | 17.03.25 | CL | BP | AS CONSTRUCTED |

| | |
|----------------|------------|
| DRAWN | STATUS |
| DESIGN | APPROVED |
| DANIEL COLLINS | RPEQ 18631 |
| | DATE |
| | 17.03.25 |

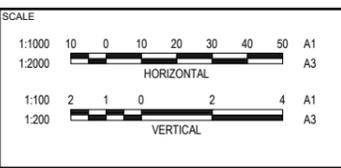

CLIENT

 ASSOCIATED CONSULTANT
 SAUNDERS HAVILL GROUP
 PH: 1300 123 744

PROJECT NAME

 STAGE 7
 133-159 PARK RIDGE ROAD, PARK RIDGE

| | | |
|--|-------------|----------|
| DRAWING TITLE | | |
| STORMWATER DRAINAGE LONGITUDINAL SECTIONS SHEET 1 OF 3 | | |
| PROJECT No. | DRAWING No. | REVISION |
| 22-0448 | 115 | 1 |



| |
|-----------------------|
| STRUCTURE NAME |
| STRUCTURE DESCRIPTION |

STORMWATER STRUCTURE NOTE:
 STANDARD ROUND MANHOLES LESS THAN 3.0m DEEP:
 CONSTRUCT IN ACCORDANCE WITH THE LOCAL AUTHORITY STANDARDS.
 STANDARD ROUND MANHOLES 3.0m > 5.3m DEEP:
 CONSTRUCT IN ACCORDANCE WITH TMR STD DRAWINGS 1307 AND 1308.
 STANDARD ROUND MANHOLES GREATER THAN 5.3m DEEP:
 SHALL BE STRUCTURALLY DESIGNED (CERTIFIED) AND CONSTRUCTED BY CONTRACTOR ON A CASE BY CASE BASIS.
 ROUND EXTENDED (900mm MAX) MANHOLES:
 CONSTRUCT IN ACCORDANCE WITH COLLIER'S STD DRAWINGS S-101 & S-102.
 NON-STANDARD STRUCTURE (SPECIAL):
 SHALL BE STRUCTURALLY DESIGNED (CERTIFIED) AND CONSTRUCTED BY CONTRACTOR ON A CASE BY CASE BASIS.

HGL EVENT
 Q100
 Q2

| |
|--------------------------|
| PIPE SIZE (mm) |
| PIPE CLASS |
| PIPE GRADE (%) |
| PIPE SLOPE (1 in X) |
| FULL PIPE VELOCITY (m/s) |
| PART FULL VELOCITY (m/s) |

| |
|------------------------------------|
| DATUM RL |
| H.G.L IN PIPE & W.S.E IN STRUCTURE |
| PIPE FLOW (Cumecs) |
| PIPE CAPACITY AT GRADE (Cumecs) |
| DEPTH TO INVERT |
| INVERT LEVEL OF DRAIN |
| DESIGN SURFACE LEVEL |
| SETOUT COORDINATES |
| RUNNING CHAINAGE |

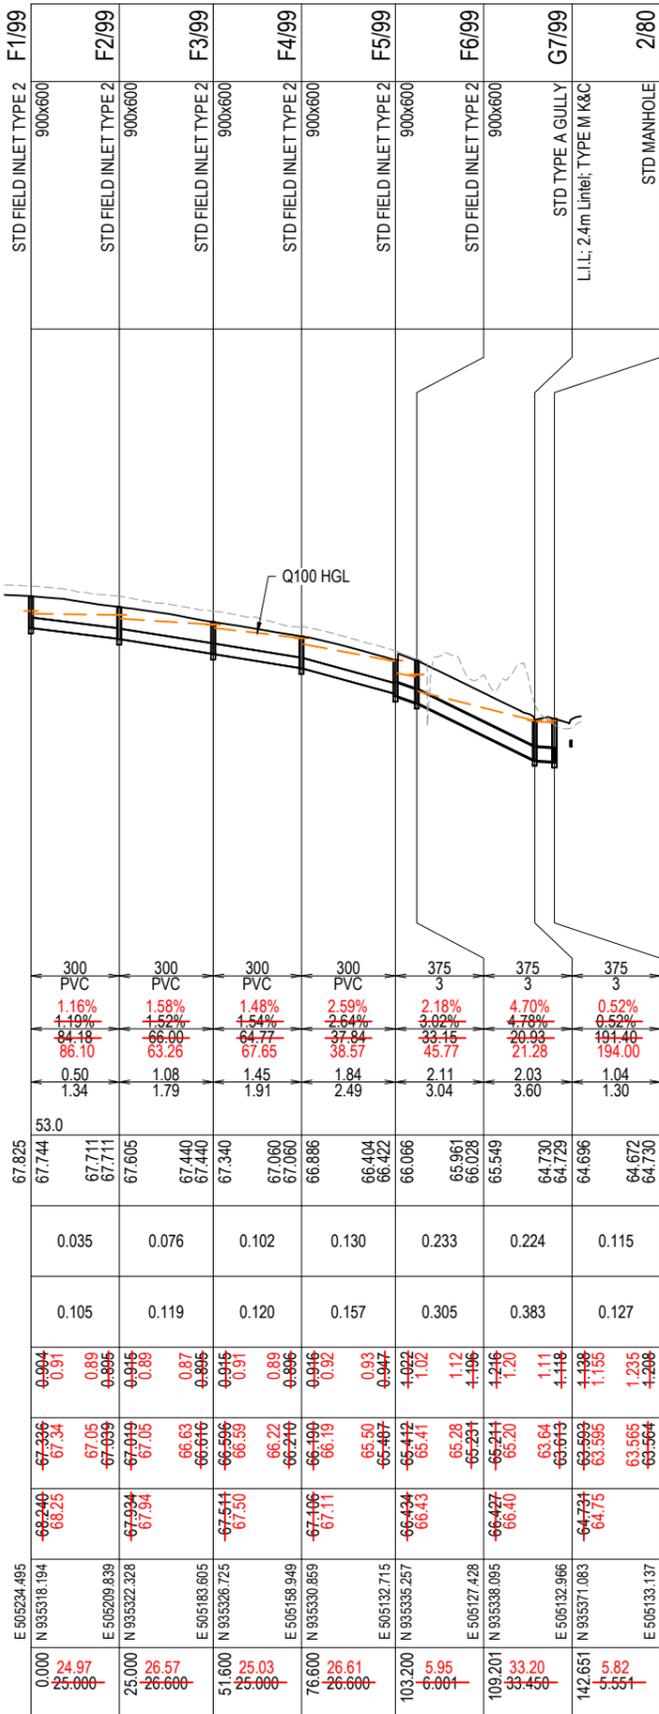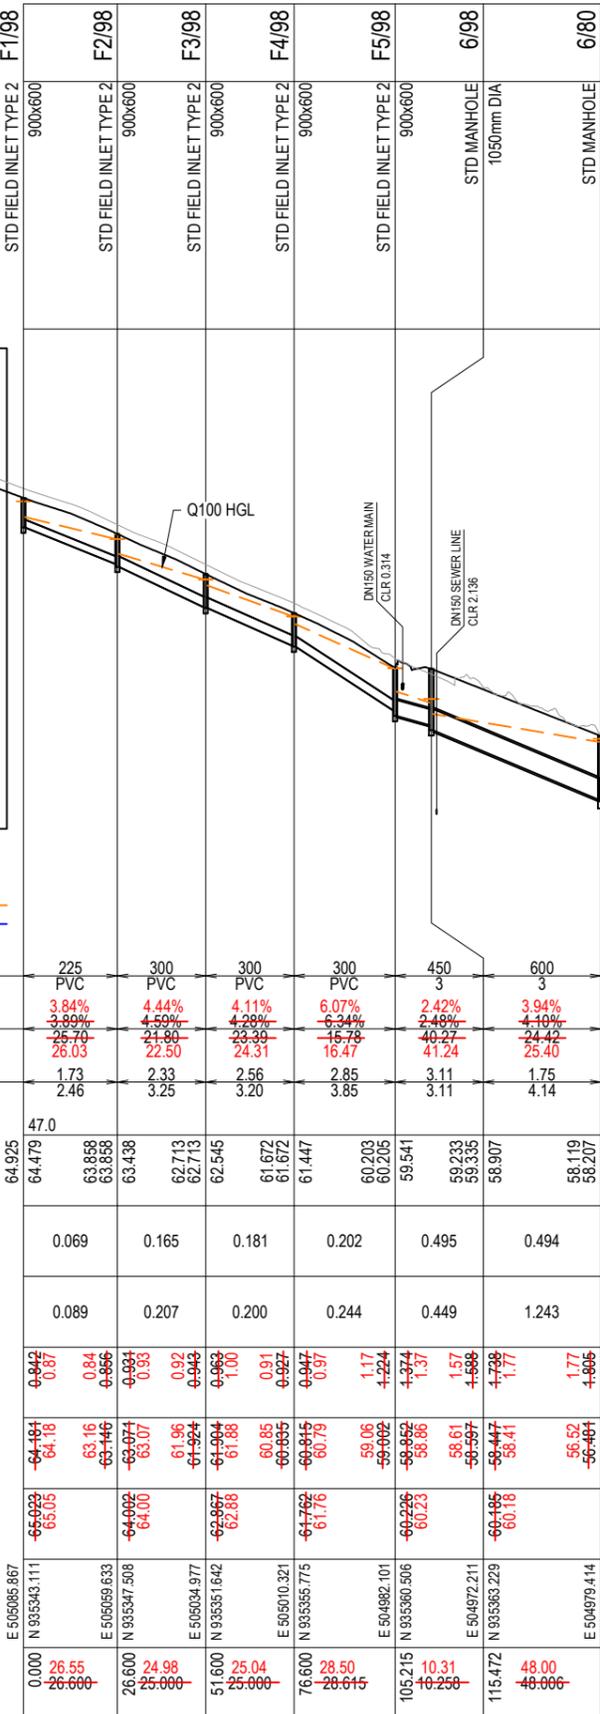


STRUCTURE SETOUT REFERENCE POINT


| STRUCTURE TYPE | HORIZONTAL | VERTICAL |
|----------------|---|------------------------|
| MANHOLE | MAIN SHAFT | FINISHED SURFACE LEVEL |
| GULLY PIT | INTERSECTION OF PIT AND KERB INVERT LNE # (INCLUDING MANHOLES UNDER GULLIES) | KERB INVERT LEVEL |
| HEADWALL | INTERSECTION OF HEADWALL FACE & PIPE CENTRE LINE | TOP OF HEADWALL |

NOTE:
 WITHIN GULLY PIT CHAMBER, CONTRACTOR TO ENSURE STORMWATER PIPES ARE OFFSET AS REQUIRED SO THAT PIPES ENTER WHOLLY WITHIN A SIDE WALL

ENGINEER'S CERTIFICATION
 I, Daniel Collins, hereby certify that:
 As Constructed information shown on this plan is a true and correct record of the sizes, types, materials, classes etc., and it corresponds with the relevant approved Engineering Drawings.
 RPEQ (signature) RPEQ No. 18631 Date: 17/03/25

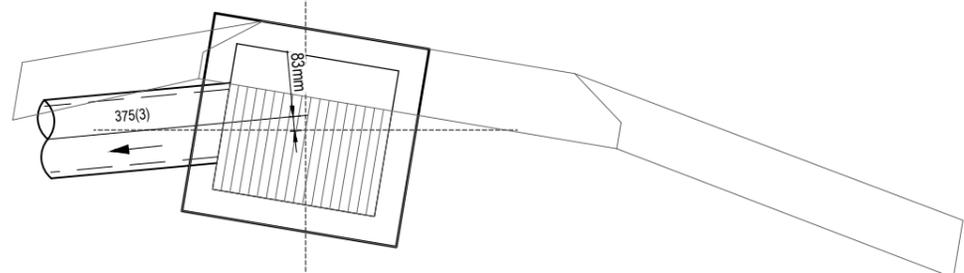

G1/87 - STD. TYPE A GULLY
 2.40m LINTEL TYPE M K&C
 1:20 (A1)
 1:40 (A3)

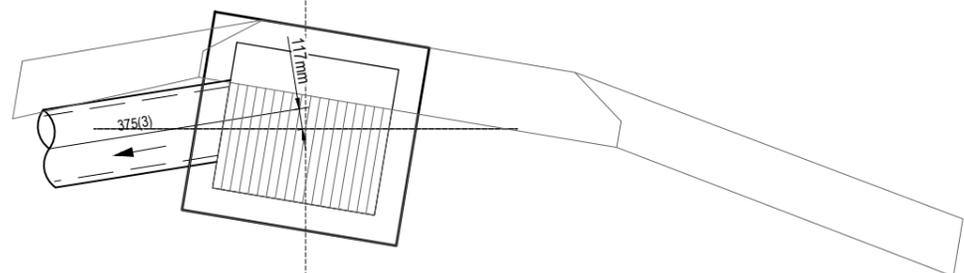


G1/93 - STD. TYPE A GULLY
 2.40m LINTEL TYPE M K&C
 1:20 (A1)
 1:40 (A3)

| REV | DATE | DESIGN | DRAWN |
|-----|----------|--------|-------|
| 0 | 26.08.24 | CL | AK |
| 1 | 17.03.25 | CL | BP |

| REVISION DETAILS |
|-------------------------|
| ISSUED FOR CONSTRUCTION |
| AS CONSTRUCTED |

| DRAWN | STATUS | |
|----------------|------------|----------|
| AS CONSTRUCTED | | |
| DESIGN | APPROVED | DATE |
| DANIEL COLLINS | RPEQ 18631 | 17.03.25 |

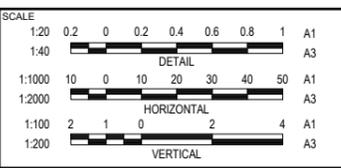

CLIENT

ASSOCIATED CONSULTANT
 SAUNDERS HAVILL GROUP
 PH: 1300 123 744

PROJECT NAME

STAGE 7
 133-159 PARK RIDGE ROAD, PARK RIDGE

| DRAWING TITLE | | |
|--|-------------|----------|
| STORMWATER DRAINAGE LONGITUDINAL SECTIONS SHEET 3 OF 3 | | |
| PROJECT No. | DRAWING No. | REVISION |
| 22-0448 | 117 | 1 |

