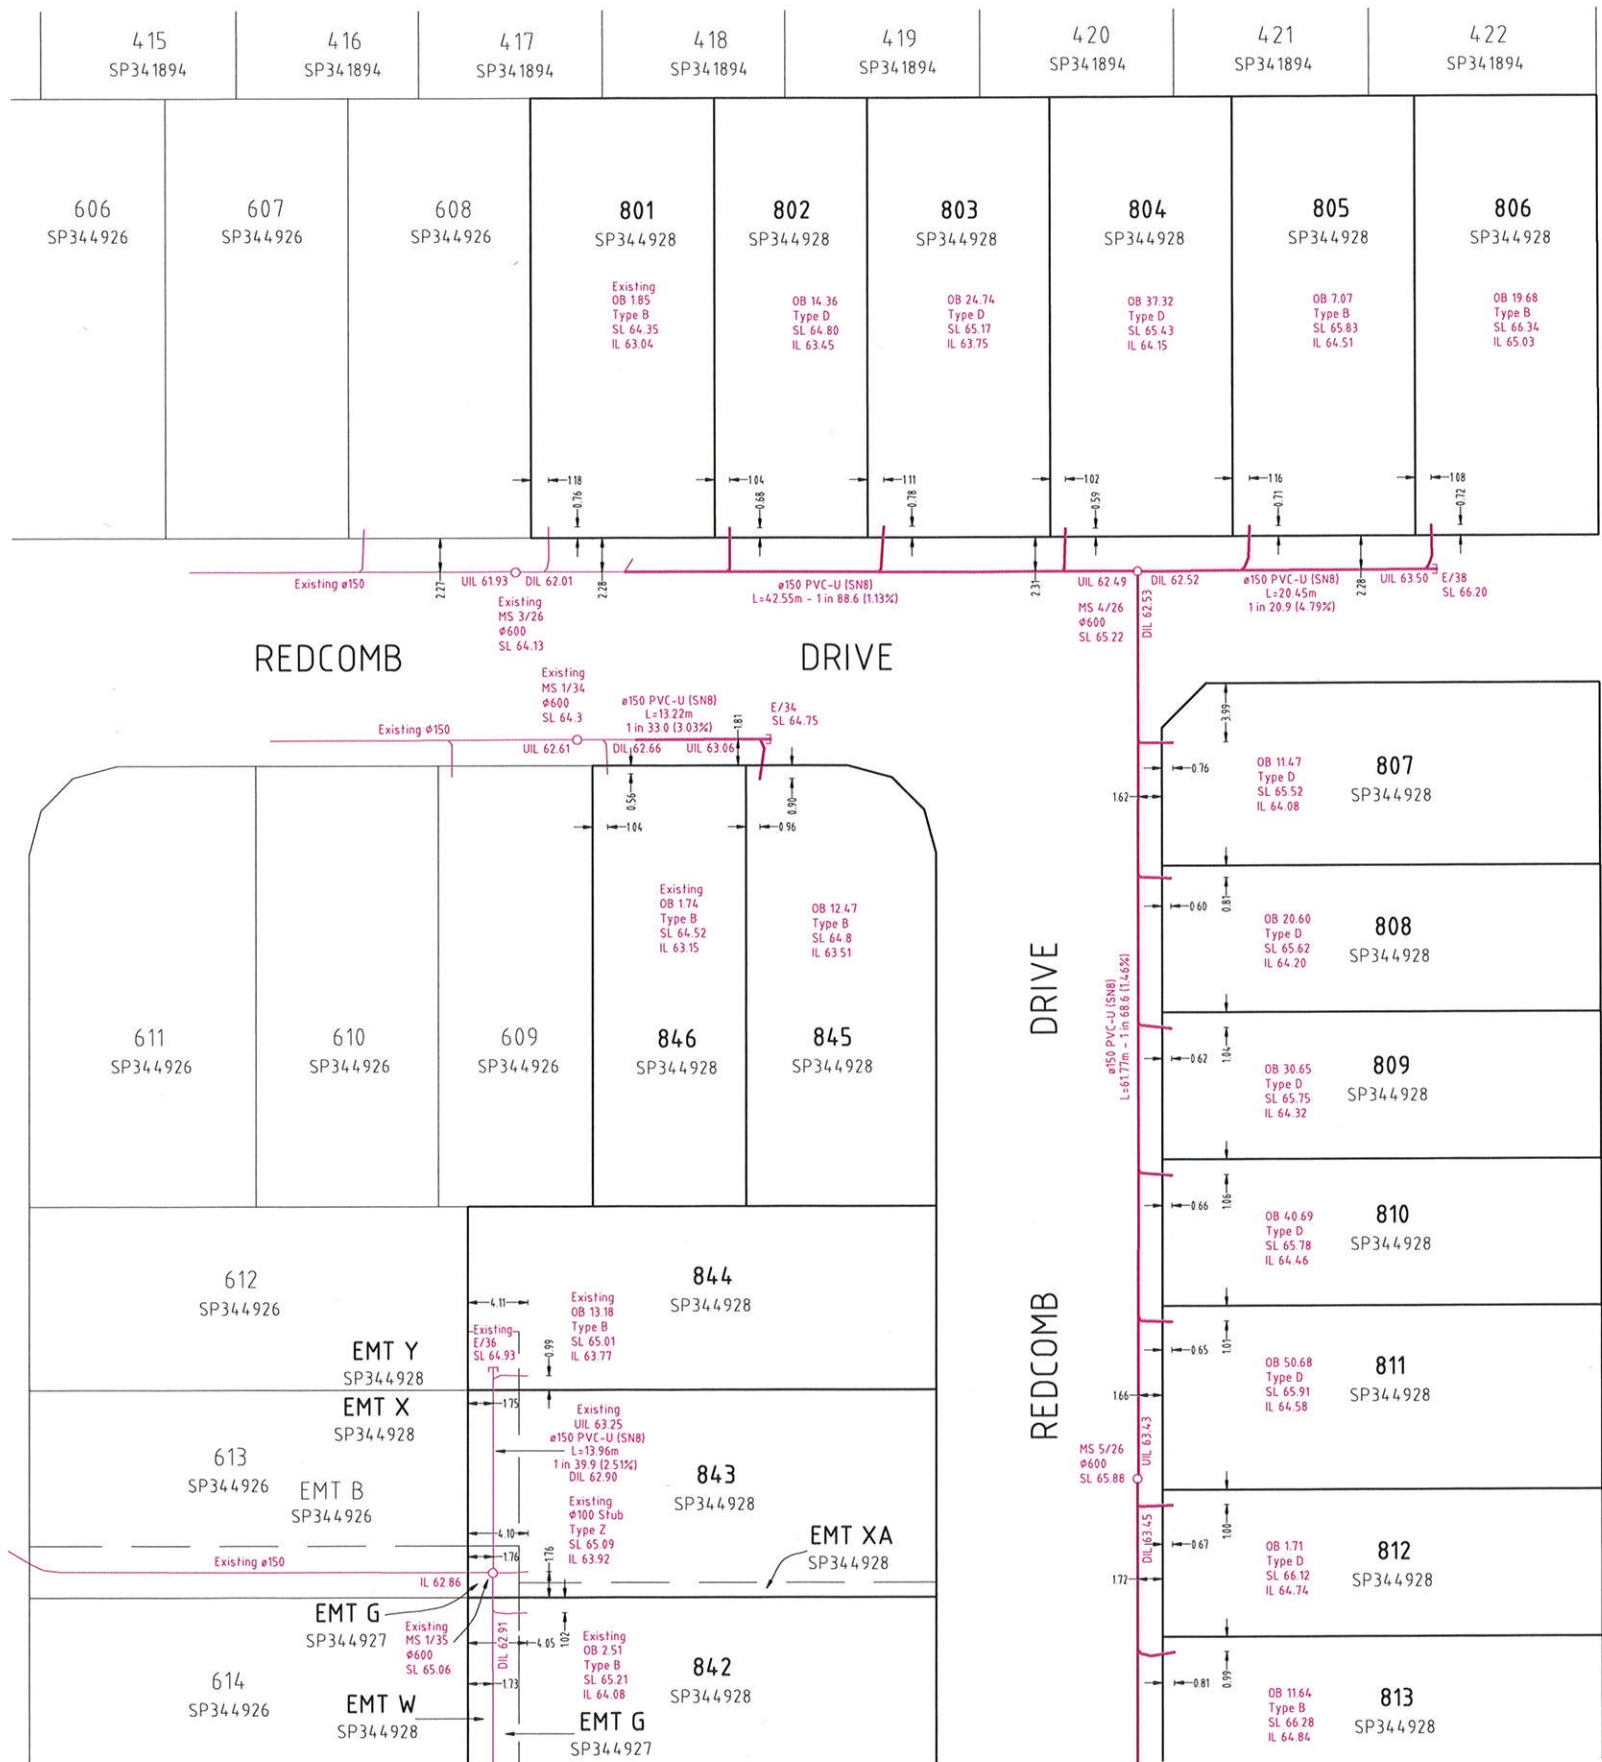




PARADE

TILLERMAN

All house connections are  $\phi 100$  unless otherwise noted.

REGISTERED SURVEYOR'S CERTIFICATION  
TILLERMAN - STAGE 8

Saunders Havill Group Pty Ltd, Registered Surveyor, hereby certify that the vertical and horizontal locations and dimensions shown on this plan are a true and correct record and were located by survey.

Authorised Signatory Reg. Surveyor No. 4611 Date: 11.06.2025

ADAC Verification Plot

Project Name: Tillerman Stage 8  
Description: Subdivision  
Works Approval ID: OW/198/2024  
Receiver: Logan City Council  
Construction date: 2025-06-10  
Status: As Constructed

ADAC version: 5.0.1  
Horizontal coordinates: MGA56 (GDA2020)  
Vertical datum: AHD  
Notes: Vertical Origin: PM70079, RL 57.043 AHD  
Surveyor: Saunders Havill Group (Reg ID 4611)  
Engineer: Colliers Engineering and Design

Note: See ADAC xml file for full attribute information

SEE SHEET 2



SCALE OF METRES  
1 : 250 FULL SIZE A1 SHEET

A1

| REV NO | DATE     | REVISION PURPOSE / DESCRIPTION | DRAWN | RPEQ | RPEQ No |
|--------|----------|--------------------------------|-------|------|---------|
| A      | 13.06.25 | Original Issue                 |       |      |         |

|          |    |            |
|----------|----|------------|
| DRAWN    | CM | 01.04.2025 |
| CHECKED  | JL | 11.06.2025 |
| APPROVED |    |            |
| INITIALS |    | DATE       |

**saunders havill group**  
Saunders Havill Group Pty Ltd ABN 24 144 972 849  
Head office 9 Thompson St Bowen Hills Q 4006  
phone 0800 823 516 web www.saundershavill.com  
a surveying & town planning & urban design & environmental management & landscape architecture

Drawing No: 10652 S 51 + 52 AC A



TILLERMAN - STAGE 8  
PARK RIDGE ROAD, PARK RIDGE  
PLAN OF ADAC SURVEY DATA  
SEWERAGE RETICULATION OW/198/2024

DRAWING STATUS  
**AS CONSTRUCTED**

SHEET 1 OF 3 SHEETS

DRAWING NO. 10652 S 51 AC  
REV. A



MANGO ROAD

SEE SHEET 1

REDCOMB DRIVE

TILLERMAN PARADE

SEE SHEET 3

All house connections are  $\phi 100$  unless otherwise noted.

### REGISTERED SURVEYOR'S CERTIFICATION TILLERMAN - STAGE 8

Saunders Havill Group Pty Ltd, Registered Surveyor, hereby certify that the vertical and horizontal locations and dimensions shown on this plan are a true and correct record and were located by survey.

*[Signature]*  
Authorised Signatory

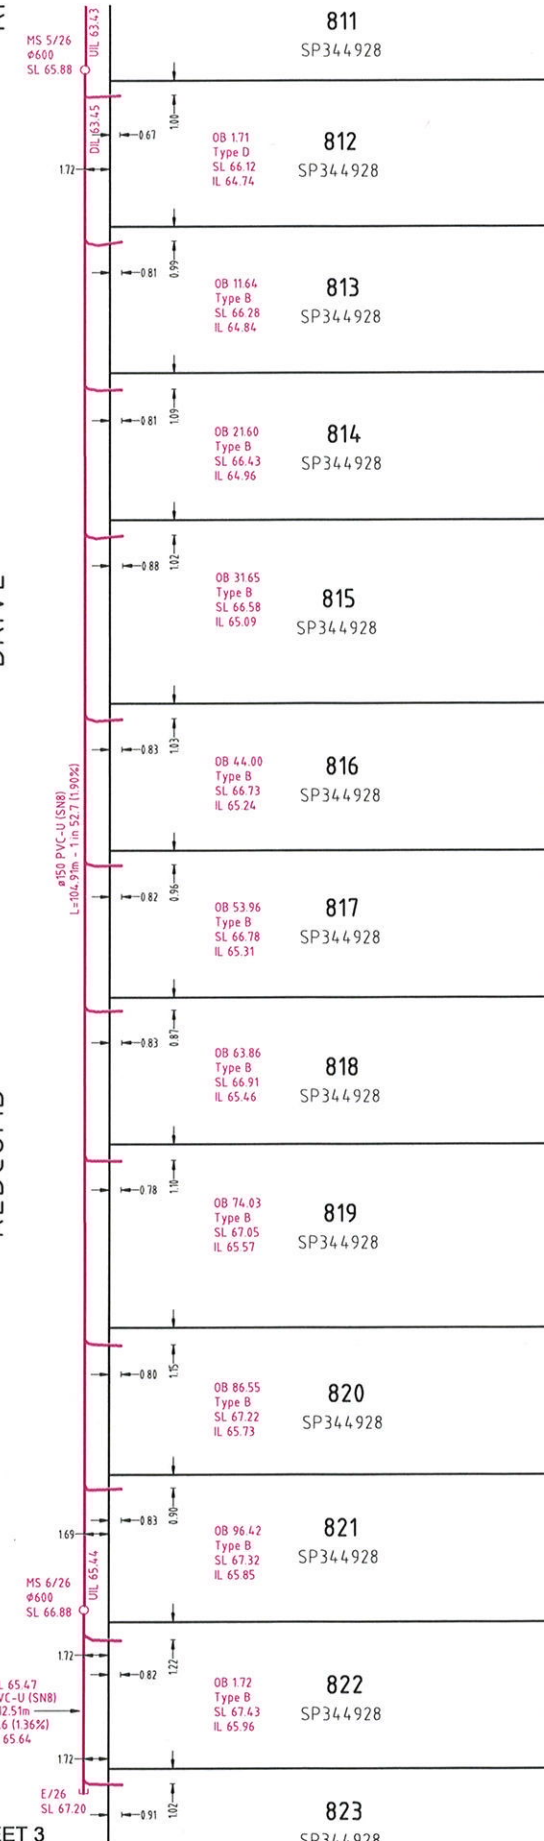
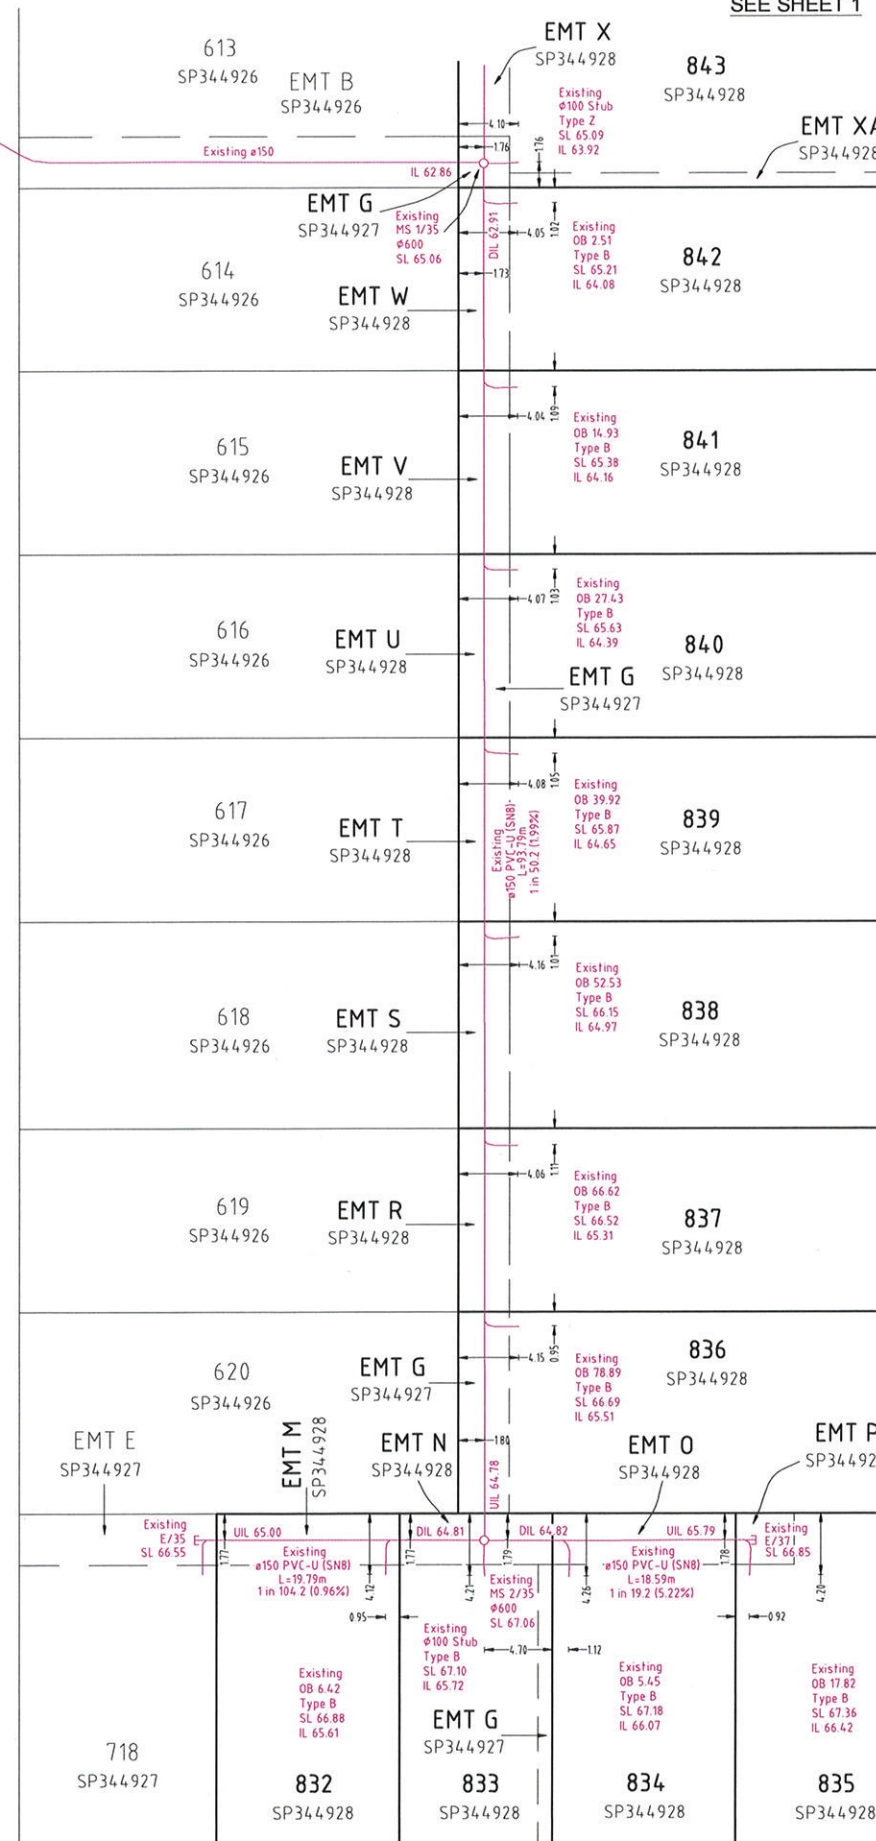
Reg. Surveyor No. 4611 Date: 11.06.2025

### ADAC Verification Plot

Project Name: Tillerman Stage 8  
Description: Subdivision  
Works Approval ID: OW/198/2024  
Receiver: Logan City Council  
Construction date: 2025-06-10  
Status: As Constructed

ADAC version: 5.0.1  
Horizontal coordinates: MGA56 (GDA2020)  
Vertical datum: AHD  
Notes: Vertical Origin PM70079, RL 57.043 AHD  
Surveyor: Saunders Havill Group (Reg ID 4611)  
Engineer: Colliers Engineering and Design

Note: See ADAC xml file for full attribute information



SCALE OF METRES  
1 : 250 FULL SIZE A1 SHEET

A1

| REV NO | DATE       | REVISION PURPOSE / DESCRIPTION | DRAWN | RPEQ | RPEQ No |
|--------|------------|--------------------------------|-------|------|---------|
| A      | 13.06.2025 | Original Issue                 |       |      |         |

| DRAWN    | CM   | 01.04.2025 |
|----------|------|------------|
| CHECKED  | JL   | 11.06.2025 |
| APPROVED |      |            |
| INITIALS | DATE |            |

**saunders havill group**  
Saunders Havill Group Pty Ltd ABN 84 144 972 949  
head office 9 Thompson St Bowen Hills Q 4006  
phone 0800 523 512 web www.saundershavill.com.au  
a surveying & town planning & urban design & environmental management & landscape architecture

**Colliers INTERNATIONAL**

**TILLERMAN**  
PARK RIDGE

**TILLERMAN - STAGE 8**  
**PARK RIDGE ROAD, PARK RIDGE**  
**PLAN OF ADAC SURVEY DATA**  
**SEWERAGE RETICULATION OW/198/2024**

| DRAWING STATUS      | AS CONSTRUCTED |
|---------------------|----------------|
| SHEET 2 OF 3 SHEETS |                |
| DRAWING NO.         | 10652 S 51 AC  |
| REV.                | A              |





MANGO ROAD

SEE SHEET 2

REDCOMB DRIVE

PARADE TILLERMAN

WALKER STREET

All house connections are  $\phi 100$  unless otherwise noted.

#### REGISTERED SURVEYOR'S CERTIFICATION

TILLERMAN - STAGE 8

Saunders Havill Group Pty Ltd, Registered Surveyor, hereby certify that the vertical and horizontal locations and dimensions shown on this plan are a true and correct record and were located by survey.

*[Signature]*  
Authorised Signatory

Reg. Surveyor No. 4611 Date: 11.06.2025

#### ADAC Verification Plot

Project Name: Tilleran Stage 8  
Description: Subdivision  
Works Approval ID: OW/198/2024  
Receiver: Logan City Council  
Construction date: 2025-06-10  
Status: As Constructed

ADAC version: 5.0.1  
Horizontal coordinates: MGA56 (GDA2020)  
Vertical datum: AHD  
Notes: Vertical Origin: PM70079, RL 57.043 AHD  
Surveyor: Saunders Havill Group (Reg ID 4611)  
Engineer: Colliers Engineering and Design

Note: See ADAC xml file for full attribute information



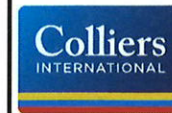
SCALE OF METRES  
1 : 250 FULL SIZE A1 SHEET

A1

| REV NO | DATE       | REVISION PURPOSE / DESCRIPTION | DRAWN | RPEQ | RPEQ No |
|--------|------------|--------------------------------|-------|------|---------|
| A      | 11.06.2025 | Original Issue                 |       |      |         |


|          |    |            |
|----------|----|------------|
| DRAWN    | CM | 01.04.2025 |
| CHECKED  | JL | 11.06.2025 |
| APPROVED |    |            |
| INITIALS |    | DATE       |

**saunders havill group**  
Saunders Havill Group Pty Ltd ABN 84 144 572 949  
Head office 9 Thompson St Bowen Hills Q 4006  
phone 0800 823 546 web www.saundershavill.com  
a surveying & town planning & urban design & environmental management & landscape architecture  
Drawing No: 10652 S 51 + 52 AC A




TILLERMAN - STAGE 8  
PARK RIDGE ROAD, PARK RIDGE  
PLAN OF ADAC SURVEY DATA  
SEWERAGE RETICULATION OW/198/2024

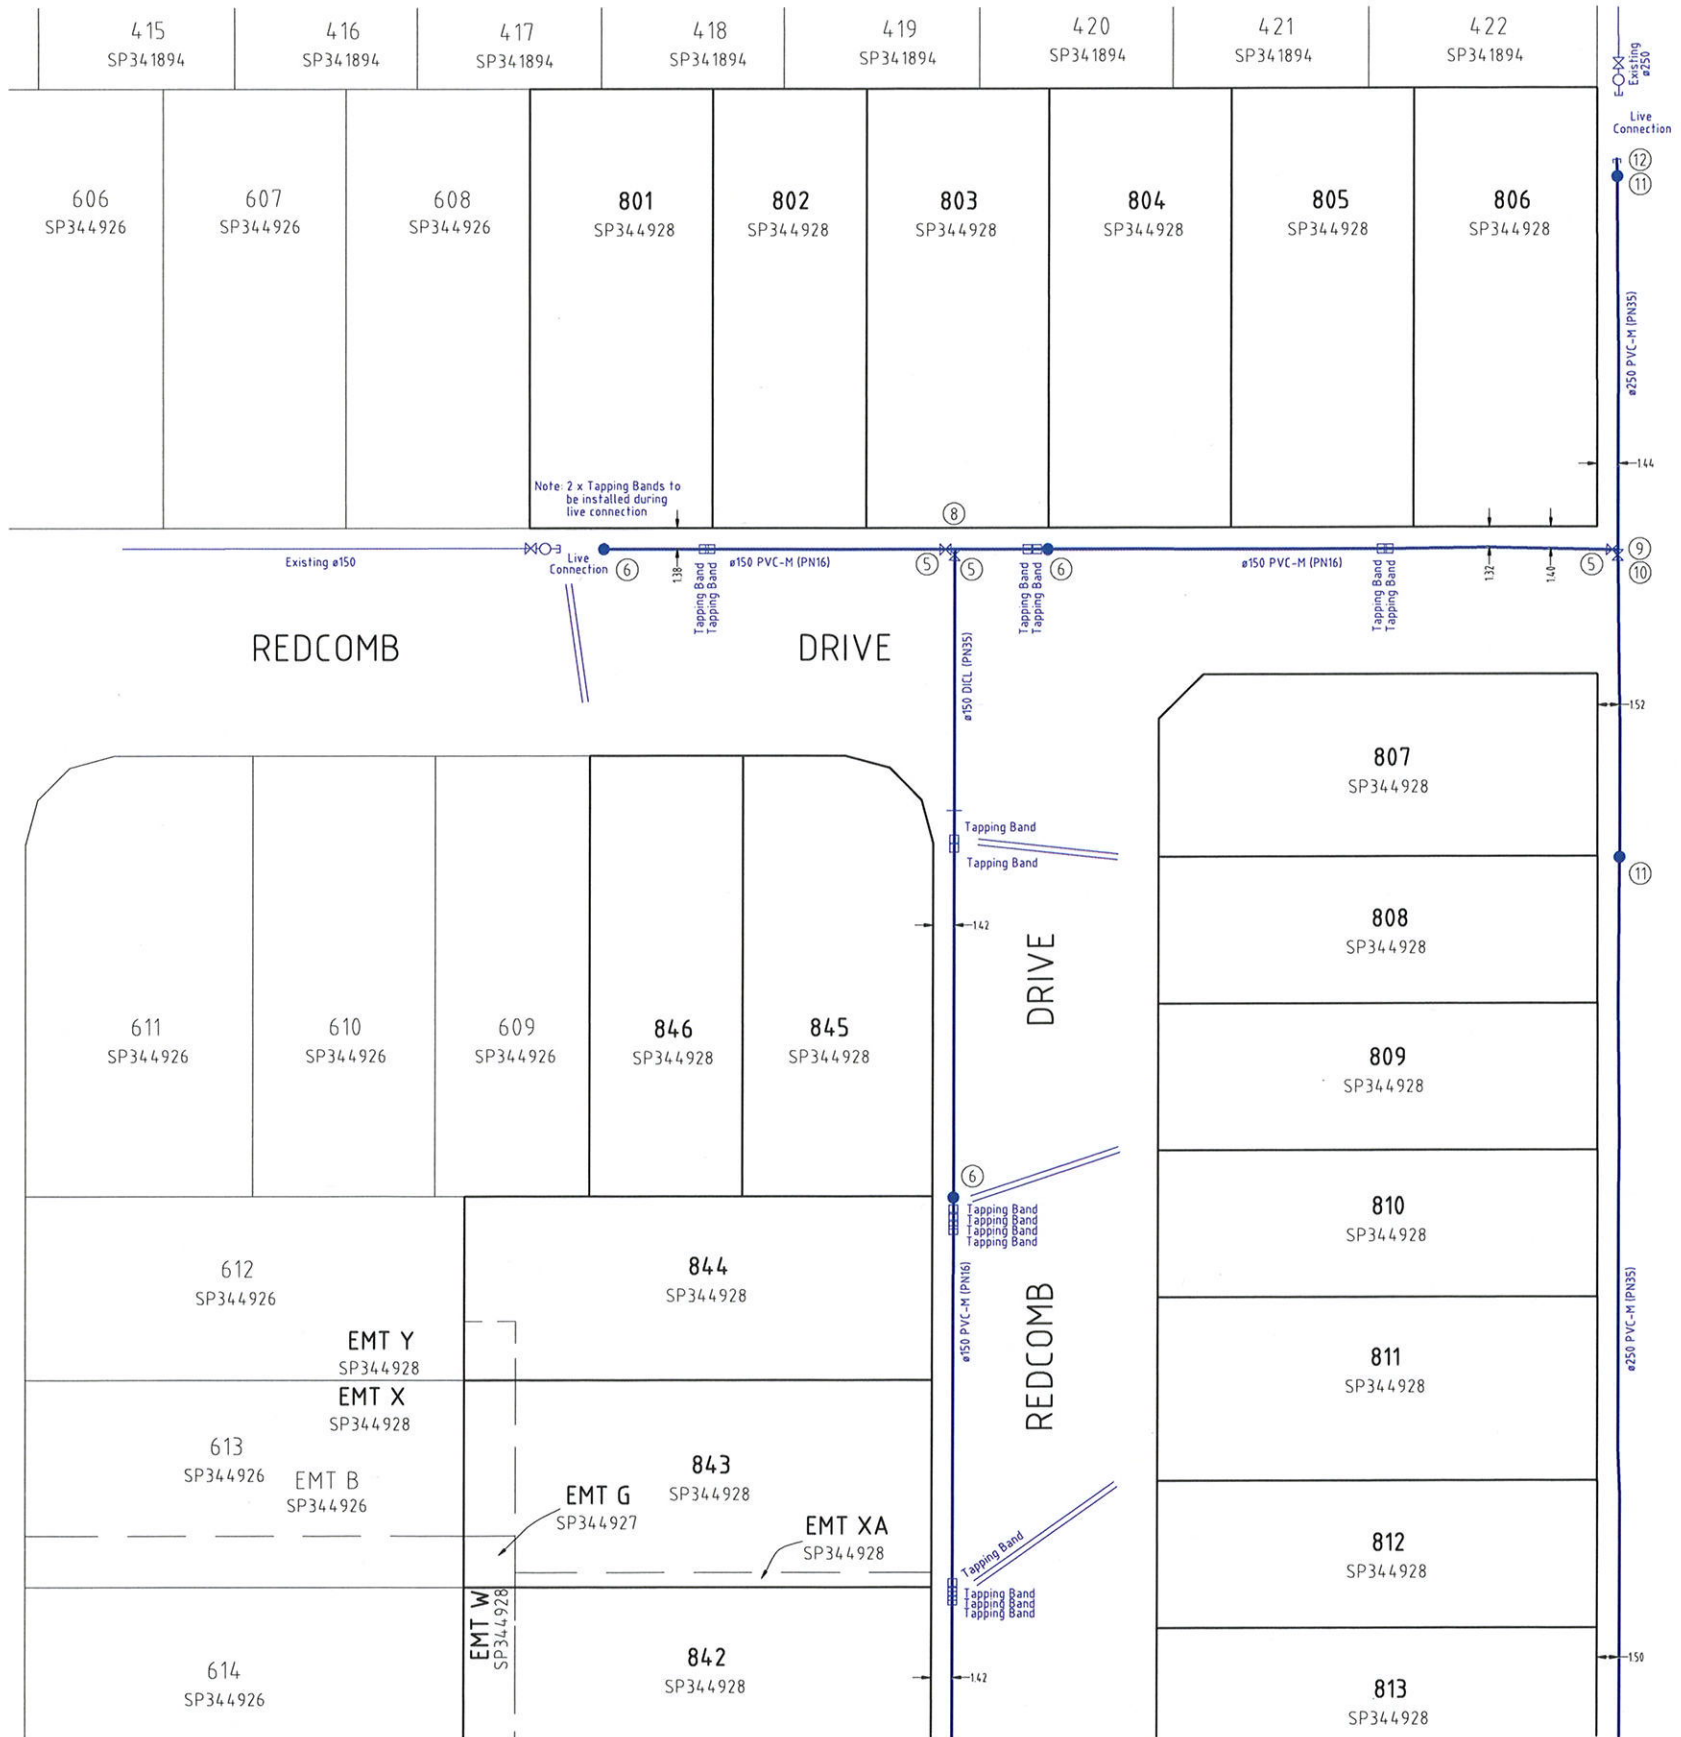DRAWING STATUS  
**AS CONSTRUCTED**  
SHEET 3 OF 3 SHEETS  
DRAWING NO. 10652 S 51 AC  
REV. A



| SCHEDULE OF FITTINGS |                    |
|----------------------|--------------------|
| ① 150 1125° Bend     | ⑦ 150 Dead End Cap |
| ② 150 22.5° Bend     | ⑧ 150 x 150 Tee    |
| ③ 150 45° Bend       | ⑨ 150 x 250 Tee    |
| ④ 150 90° Bend       | ⑩ 250 Valve        |
| ⑤ 150 Valve          | ⑪ 250 Hydrant      |
| ⑥ 150 Hydrant        | ⑫ 250 Dead End Cap |

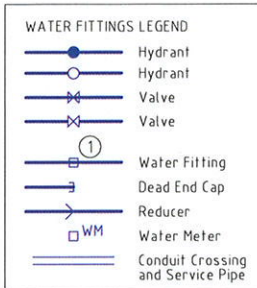

Note: See ADAC xml file for full attribute information

#### REGISTERED SURVEYOR'S CERTIFICATION TILLERMAN - STAGE 8

Saunders Havill Group Pty Ltd, Registered Surveyor, hereby certify that the vertical and horizontal locations and dimensions shown on this plan are a true and correct record and were located by survey.

Authorised Signatory Reg. Surveyor No. 4611 Date: 13.06.2025

#### ADAC Verification Plot

Project Name: Tillerman Stage 8  
Description: Subdivision  
Works Approval ID: OW/198/2024  
Receiver: Logan City Council  
Construction date: 2025-06-10  
Status: As Constructed

ADAC version: 5.0.1  
Horizontal coordinates: MGA56 (GDA2020)  
Vertical datum: AHD  
Notes: Vertical Origin: PM70079, RL 57.043 AHD  
Surveyor: Saunders Havill Group (Reg ID 4611)  
Engineer: Colliers Engineering and Design

Note: See ADAC xml file for full attribute information

SEE SHEET 2

2 0 2 4 6 8 10  
SCALE OF METRES  
1 : 250 FULL SIZE A1 SHEET

A1

| REV NO | DATE       | REVISION PURPOSE / DESCRIPTION | DRAWN | RPEQ | RPEQ No |
|--------|------------|--------------------------------|-------|------|---------|
| A      | 05.06.2025 | Original Issue                 |       |      |         |

|          |    |            |
|----------|----|------------|
| DRAWN    | CM | 01.04.2025 |
| CHECKED  | JL | 13.06.2025 |
| APPROVED |    |            |
| INITIALS |    | DATE       |

**saunders havill group**  
Saunders Havill Group Pty Ltd ABN 24 144 972 549  
Head office 9 Thompson St Bowen Hills Q 4006  
phone 0300 839 5146 web www.saundershavill.com  
a surveying a town planning a urban design a environmental management a landscape a architecture  
Drawing No: 10652 S 51 + 52 AC A



**TILLERMAN - STAGE 8  
PARK RIDGE ROAD, PARK RIDGE**  
**PLAN OF ADAC SURVEY DATA  
WATER RETICULATION OW/198/2024**

|                                         |           |
|-----------------------------------------|-----------|
| DRAWING STATUS<br><b>AS CONSTRUCTED</b> |           |
| SHEET 1 OF 3 SHEETS                     |           |
| DRAWING NO.<br>10652 S 52 AC            | REV.<br>A |





SEE SHEET 1

ROAD

MANGO

DRIVE

REDCOMB

PARADE

TILLERMAN

| WATER FITTINGS LEGEND |                                   |
|-----------------------|-----------------------------------|
|                       | Hydrant                           |
|                       | Hydrant                           |
|                       | Valve                             |
|                       | Valve                             |
|                       | Water Fitting                     |
|                       | Dead End Cap                      |
|                       | Reducer                           |
|                       | Water Meter                       |
|                       | Conduit Crossing and Service Pipe |

Note: See ADAC xml file for full attribute information

| SCHEDULE OF FITTINGS     |                               |
|--------------------------|-------------------------------|
| ① $\phi$ 150 11.25° Bend | ⑦ $\phi$ 150 Dead End Cap     |
| ② $\phi$ 150 22.5° Bend  | ⑧ $\phi$ 150 x $\phi$ 150 Tee |
| ③ $\phi$ 150 45° Bend    | ⑨ $\phi$ 150 x $\phi$ 250 Tee |
| ④ $\phi$ 150 90° Bend    | ⑩ $\phi$ 250 Valve            |
| ⑤ $\phi$ 150 Valve       | ⑪ $\phi$ 250 Hydrant          |
| ⑥ $\phi$ 150 Hydrant     | ⑫ $\phi$ 250 Dead End Cap     |

**REGISTERED SURVEYOR'S CERTIFICATION**  
TILLERMAN - STAGE 8

Saunders Havill Group Pty Ltd, Registered Surveyor, hereby certify that the vertical and horizontal locations and dimensions shown on this plan are a true and correct record and were located by survey.

*[Signature]*  
Authorised Signatory Reg. Surveyor No. 4611 Date: 13.06.2025

**ADAC Verification Plot**

Project Name: Tillerman Stage 8  
Description: Subdivision  
Works Approval ID: OW/198/2024  
Receiver: Logan City Council  
Construction date: 2025-06-10  
Status: As Constructed

ADAC version: 5.0.1  
Horizontal coordinates: MGA56 (GDA2020)  
Vertical datum: AHD  
Notes: Vertical Origin: PM70079, RL 57.043 AHD  
Surveyor: Saunders Havill Group (Reg ID 4611)  
Engineer: Colliers Engineering and Design

Note: See ADAC xml file for full attribute information

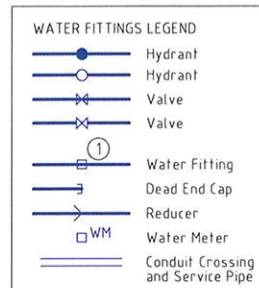
|                   |                   |                   |                   |                   |                    |
|-------------------|-------------------|-------------------|-------------------|-------------------|--------------------|
| 613<br>SP344926   | EMT B<br>SP344926 | EMT X<br>SP344928 | 843<br>SP344928   | EMT G<br>SP344927 | EMT XA<br>SP344928 |
| 614<br>SP344926   | EMT W<br>SP344928 |                   | 842<br>SP344928   |                   |                    |
| 615<br>SP344926   | EMT V<br>SP344928 |                   | 841<br>SP344928   |                   |                    |
| 616<br>SP344926   | EMT U<br>SP344928 |                   | 840<br>SP344928   |                   |                    |
| 617<br>SP344926   | EMT T<br>SP344928 |                   | 839<br>SP344928   |                   |                    |
| 618<br>SP344926   | EMT S<br>SP344928 |                   | 838<br>SP344928   |                   |                    |
| 619<br>SP344926   | EMT R<br>SP344928 |                   | 837<br>SP344928   |                   |                    |
| 620<br>SP344926   | EMT G<br>SP344927 |                   | 836<br>SP344928   |                   |                    |
| EMT E<br>SP344927 | EMT M<br>SP344928 | EMT N<br>SP344928 | EMT O<br>SP344928 | EMT P<br>SP344928 |                    |
| 718<br>SP344927   | 832<br>SP344928   | 833<br>SP344928   | 834<br>SP344928   | 835<br>SP344928   |                    |

|                 |  |
|-----------------|--|
| 811<br>SP344928 |  |
| 812<br>SP344928 |  |
| 813<br>SP344928 |  |
| 814<br>SP344928 |  |
| 815<br>SP344928 |  |
| 816<br>SP344928 |  |
| 817<br>SP344928 |  |
| 818<br>SP344928 |  |
| 819<br>SP344928 |  |
| 820<br>SP344928 |  |
| 821<br>SP344928 |  |
| 822<br>SP344928 |  |
| 823<br>SP344928 |  |



SEE SHEET 3

| |
|---|
| A1 | |
|---|



Note: See ADAC xml file for full attribute information

| SCHEDULE OF FITTINGS |                    |  |  |
|----------------------|--------------------|--|--|
| ① 150 11.25° Bend    | ⑦ 150 Dead End Cap |  |  |
| ② 150 22.5° Bend     | ⑧ 150 x 150 Tee    |  |  |
| ③ 150 45° Bend       | ⑨ 150 x 250 Tee    |  |  |
| ④ 150 90° Bend       | ⑩ 250 Valve        |  |  |
| ⑤ 150 Valve          | ⑪ 250 Hydrant      |  |  |
| ⑥ 150 Hydrant        | ⑫ 250 Dead End Cap |  |  |

**REGISTERED SURVEYOR'S CERTIFICATION**  
TILLERMAN - STAGE 8

Saunders Havill Group Pty Ltd, Registered Surveyor, hereby certify that the vertical and horizontal locations and dimensions shown on this plan are a true and correct record and were located by survey.

Authorised Signatory Reg. Surveyor No. 4611 Date: 13.06.2025

**ADAC Verification Plot**

Project Name: Tillerman Stage 8  
Description: Subdivision  
Works Approval ID: OW/198/2024  
Receiver: Logan City Council  
Construction date: 2025-06-10  
Status: As Constructed

ADAC version: 5.0.1  
Horizontal coordinates: MGA56 (GDA2020)  
Vertical datum: AHD  
Notes: Vertical Origin: PM70079, RL 57.043 AHD  
Surveyor: Saunders Havill Group (Reg ID 4611)  
Engineer: Colliers Engineering and Design

Note: See ADAC xml file for full attribute information



SCALE OF METRES  
1 : 250 FULL SIZE A1 SHEET

| |
|---|
| A1 | |
|---|