


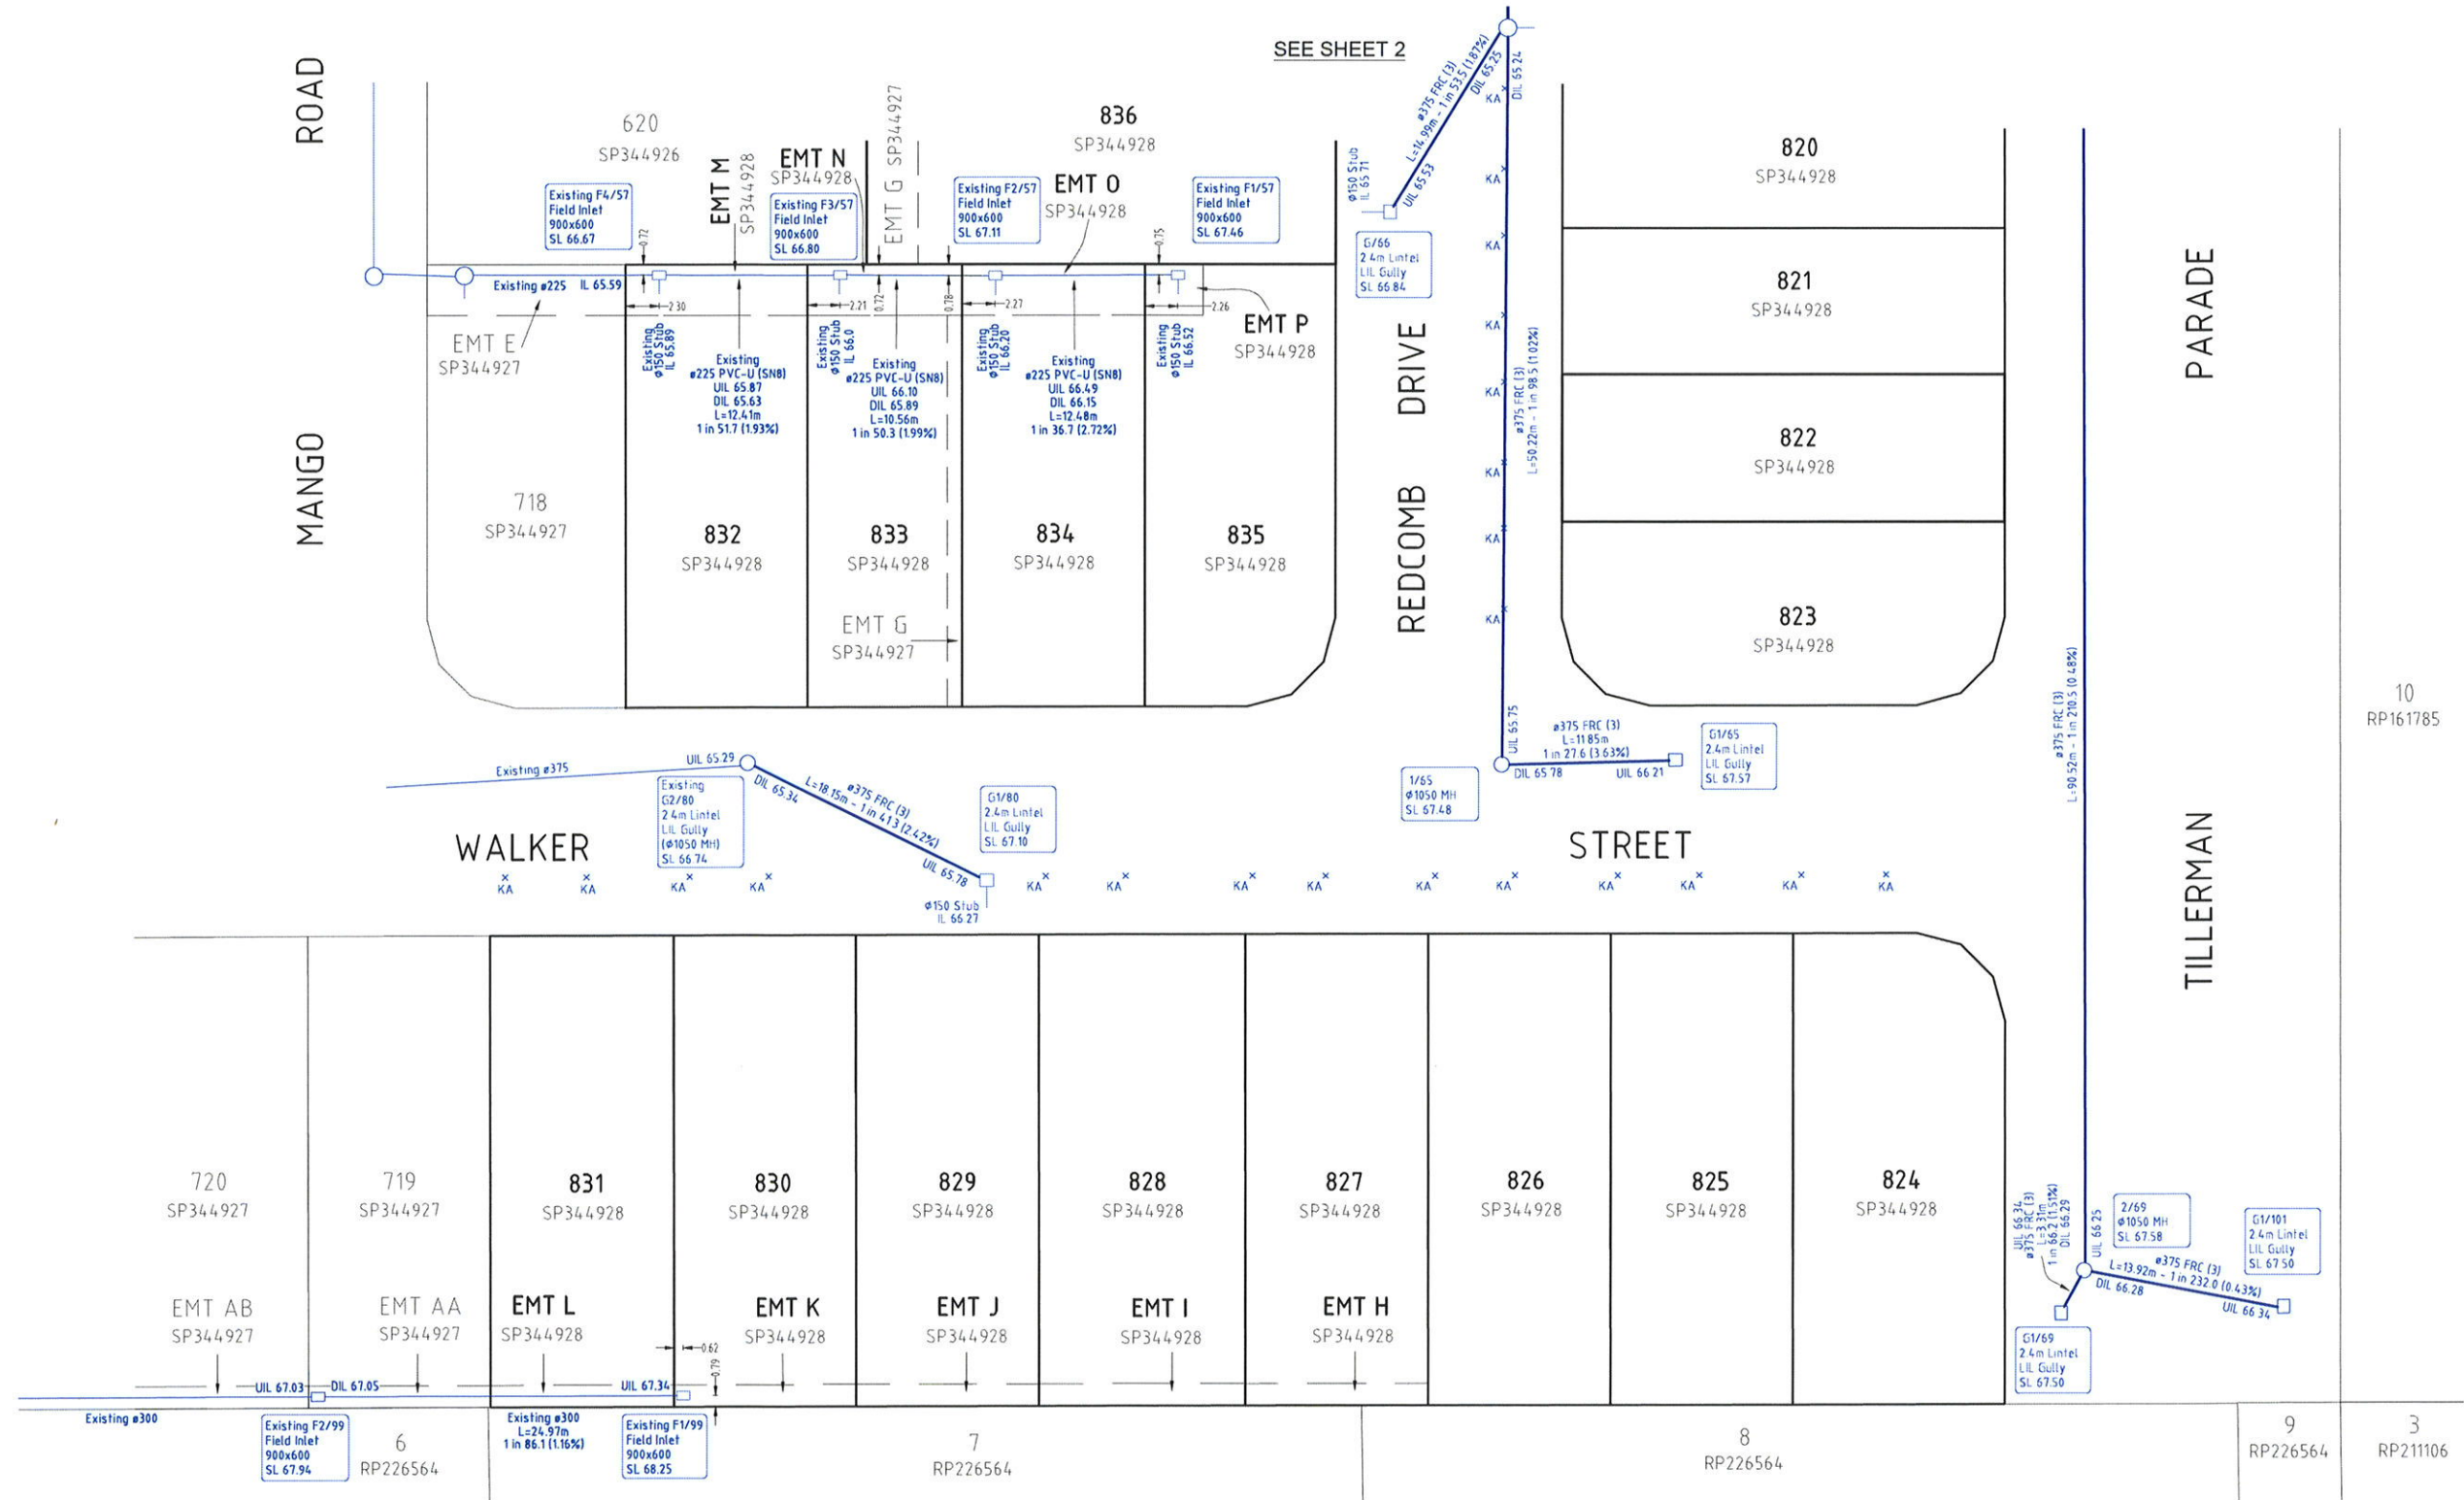

ADAC Verification Plot

Project Name: Tillerman Stage 8
Description: Subdivision
Works Approval ID: OW/198/2024
Receiver: Logan City Council
Construction date: 2025-06-10
Status: As Constructed

ADAC version: 5.0.1
Horizontal coordinates: MGA56 (GDA2020)
Vertical datum: AHD
Notes: Vertical Origin: PM70079, RL 57.043 AHD
Surveyor: Saunders Havill Group (Reg ID 4611)
Engineer: Colliers Engineering and Design

Note: See ADAC xml file for full attribute information

REGISTERED SURVEYOR'S CERTIFICATION TILLERMAN - STAGE 8


Saunders Havill Group Pty Ltd, Registered Surveyor, hereby certify that the vertical and horizontal locations and dimensions shown on this plan are a true and correct record and were located by survey.

Authorised Signatory: *[Signature]* Reg. Surveyor No. 4611 Date: 18/07/2025

CONSULTING ENGINEER'S CERTIFICATION TILLERMAN - STAGE 8

I, *[Signature]*, hereby certify that the As Constructed information shown on this plan is a true and correct record of the sizes, types, materials, classes etc., and it corresponds with the relevant approved Engineering Drawings.

Signed: *[Signature]* RPEQ No: *[Blank]* Date: *[Blank]*

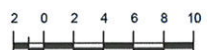

SCALE OF METRES
1 : 250 FULL SIZE A1 SHEET

A1

REV NO	DATE	REVISION PURPOSE / DESCRIPTION	DRAWN	RPEQ	RPEQ No
A	18.07.2025	Original Issue			

DRAWN	CM	07.07.2025
CHECKED	SJS	18.07.2025
APPROVED		



Saunders Havill
BOWEN HILLS | SPRINGFIELD
1300 123 744 | info@saundershavill.com

Drawing No: 10652 S 51 + 52 + 53 AC B



TILLERMAN - STAGE 8
PARK RIDGE ROAD, PARK RIDGE
PLAN OF ADAC SURVEY DATA
STORMWATER DRAINAGE OW/198/2024

DRAWING STATUS	AS CONSTRUCTED
SHEET 3 OF 3 SHEETS	
DRAWING NO.	10652 S 53 AC
REV.	A